


# T.27S.R.6W.W.M.

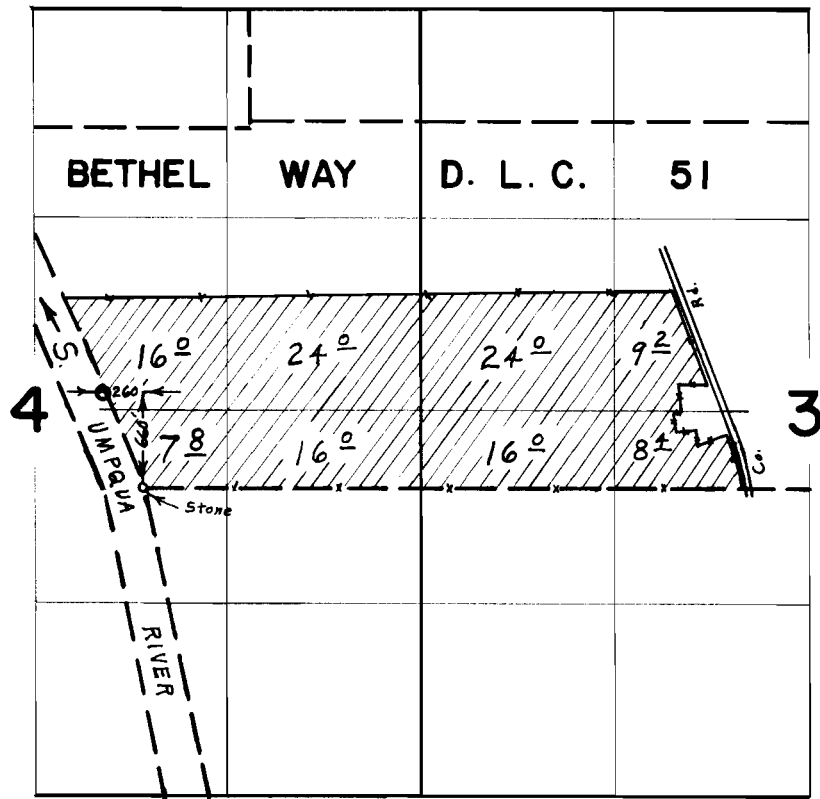

## FINAL PROOF SURVEY UNDER

Application No. 37557. Permit No. 27985.  
IN NAME OF  
**G. W. TIPTON**

Surveyed May 19, 1966, by L. E. Gould.