FINAL PROOF SURVEY

UNDER

Application No. R-21599 Permit No. R-837
21600 16908
R-23384 R-959
23476 18571

IN NAME OF EVERETT & BETTY HILBERT

T.30S.R.31 & 32E.W.M.

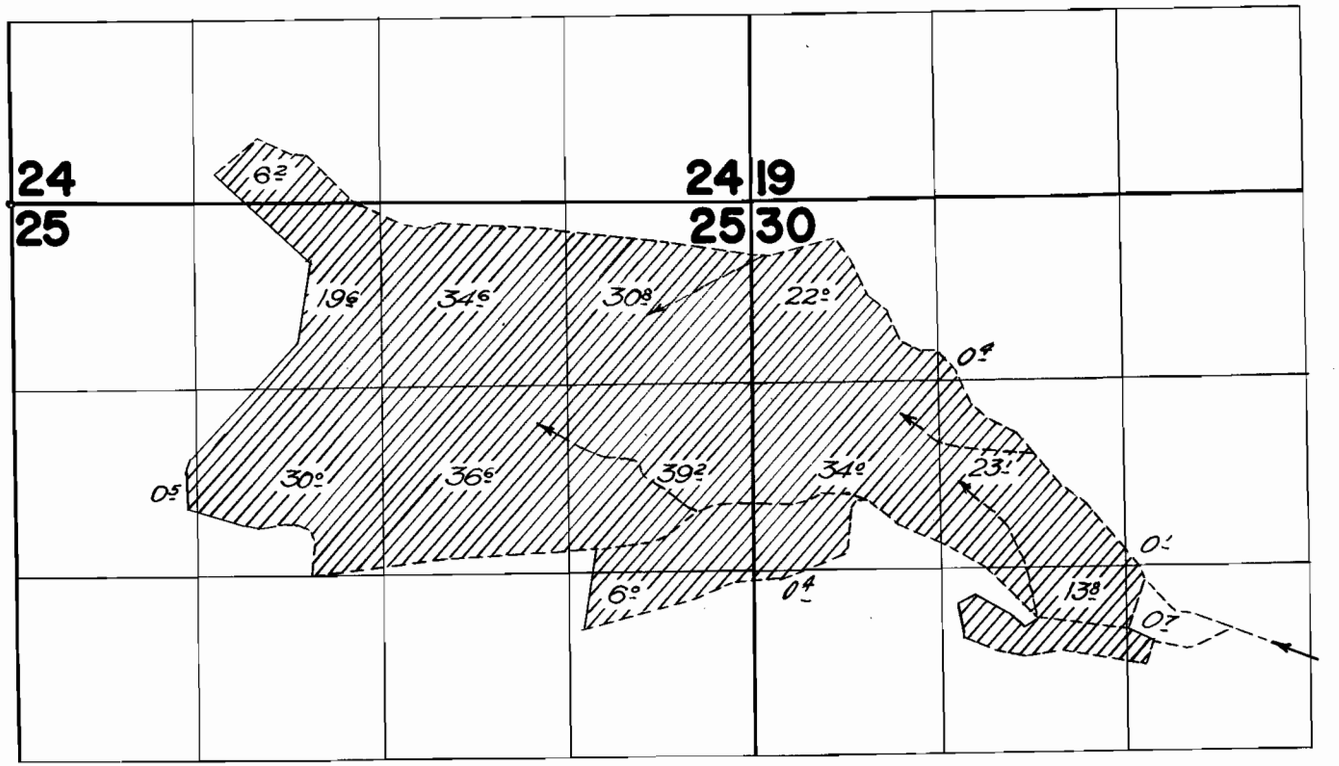

T.30 & 31S.R.32 & 32½E.W.M.

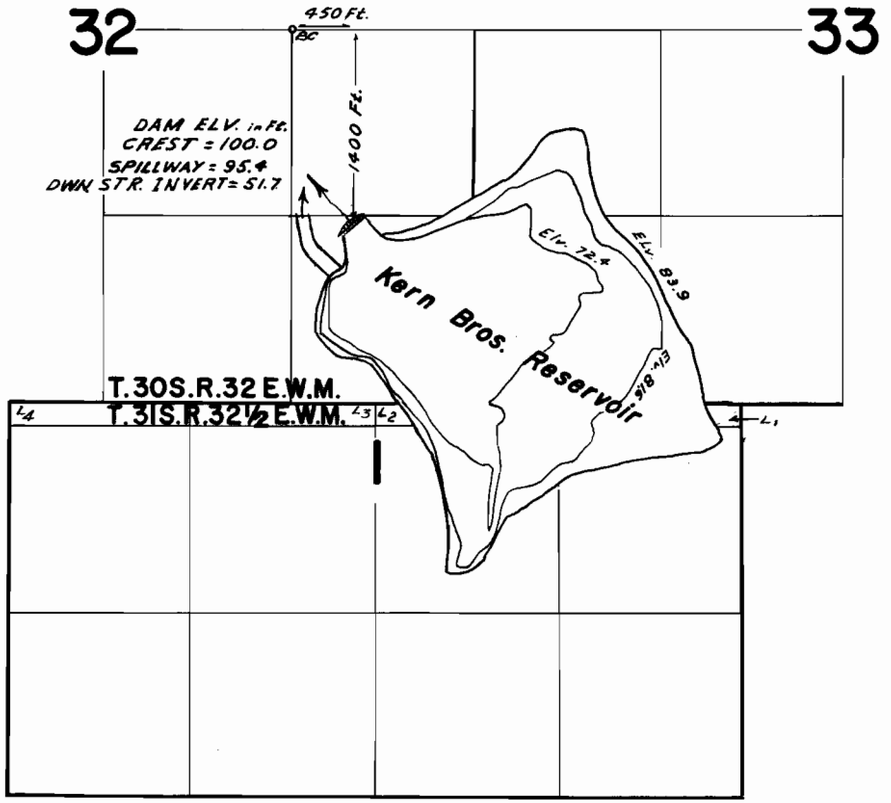

Surveyed Sept. 16 & 17, 1963 by T. Lauer
SEPT. 16, 1965 by L. COLEBANK