


# FINAL PROOF SURVEY

UNDER


Application No. R-21599    Permit No. R-837  
 21600                            16908  
 R-23384                        R-959  
 23476                            18571

IN NAME OF EVERETT & BETTY HILBERT

T.30S.R.31 & 32 E.W.M.

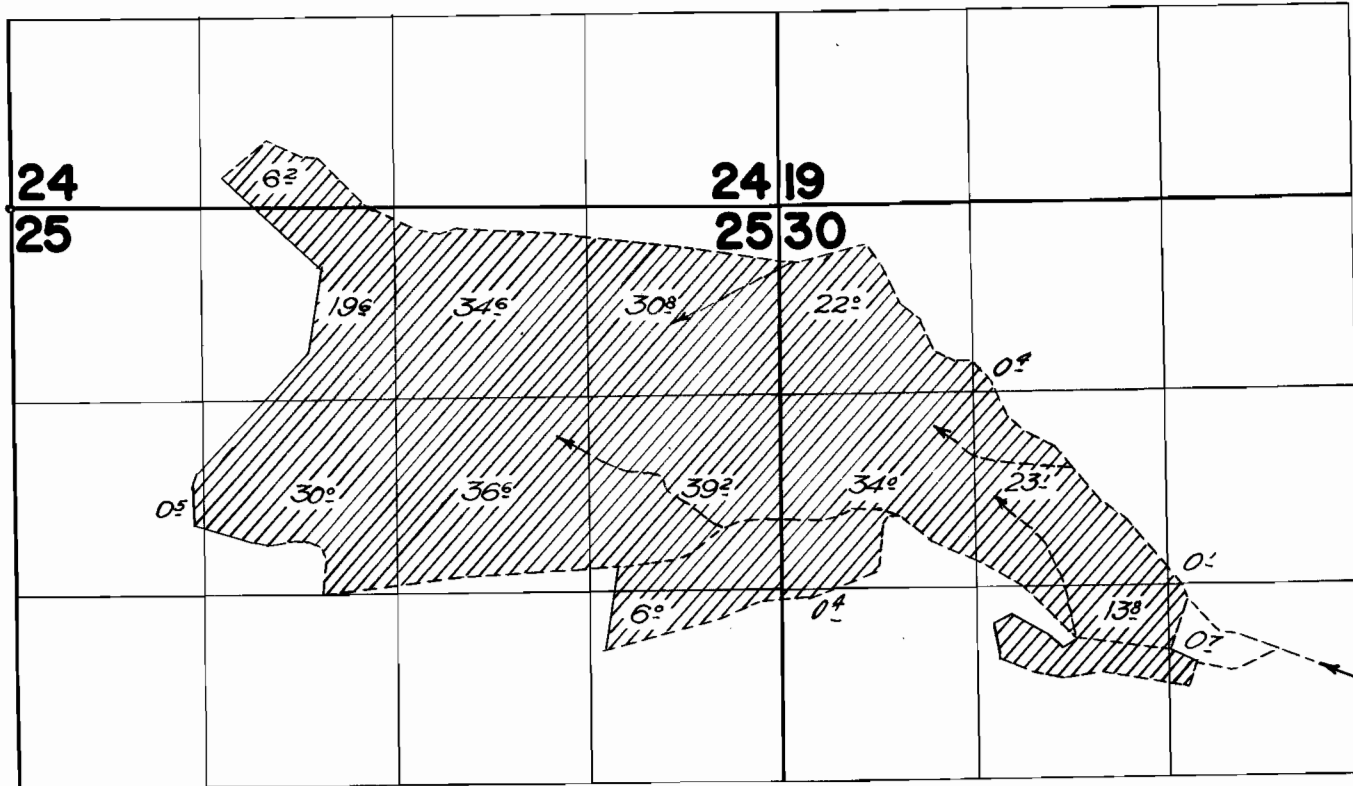

T.30 & 31S.R.32 & 32 1/2 E.W.M.

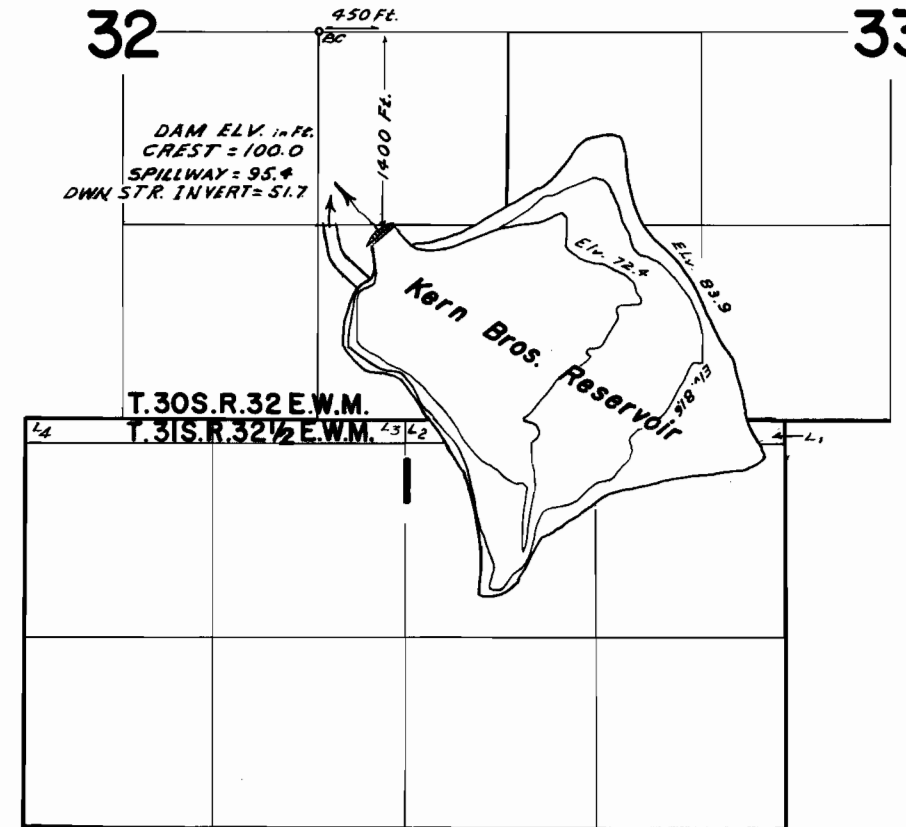

Surveyed Sept. 16 & 17, 1963 by T. Lauer  
 SEPT. 16, 1965 by L. COLEBANK