


T. 35 S. R. 2 W. W.M

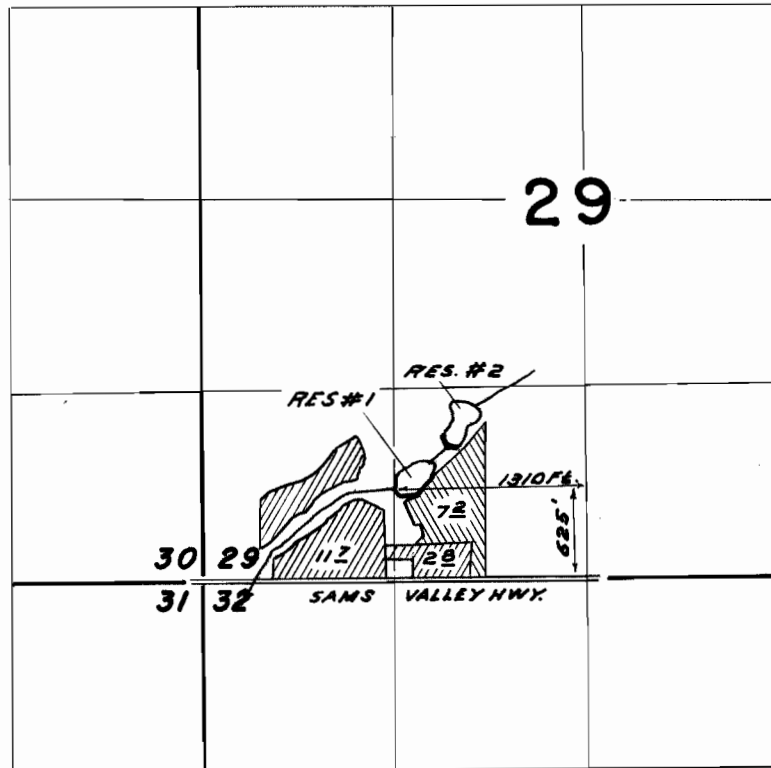

SUPPLEMENTAL  PRIMARY

FINAL PROOF SURVEY
UNDER

R-39068 R-3868
Application No. 39069 Permit No. 29169
IN NAME OF
LESTER T. CONN

Surveyed JULY 14 1965, by L. COLEBANK