


T. 36 S. R. 4 & 5 W. W.M.

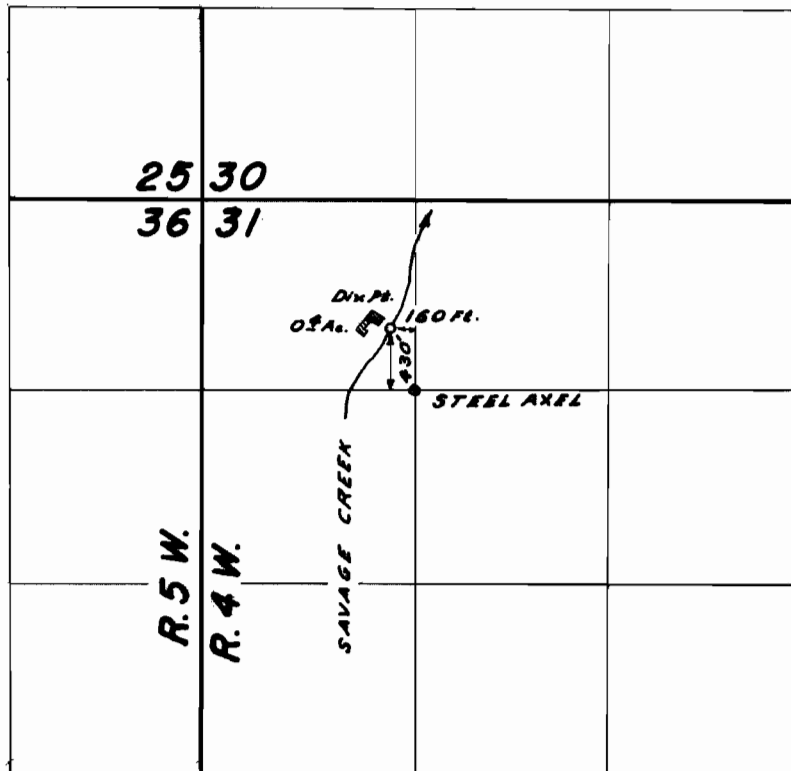

FINAL PROOF SURVEY
UNDER

Application No. 34195 Permit No. 26941
IN NAME OF

GUY R. PAGE

Surveyed JULY 22 1965, by L. COLEBANK