


# T.36S. R.2W. W.M.

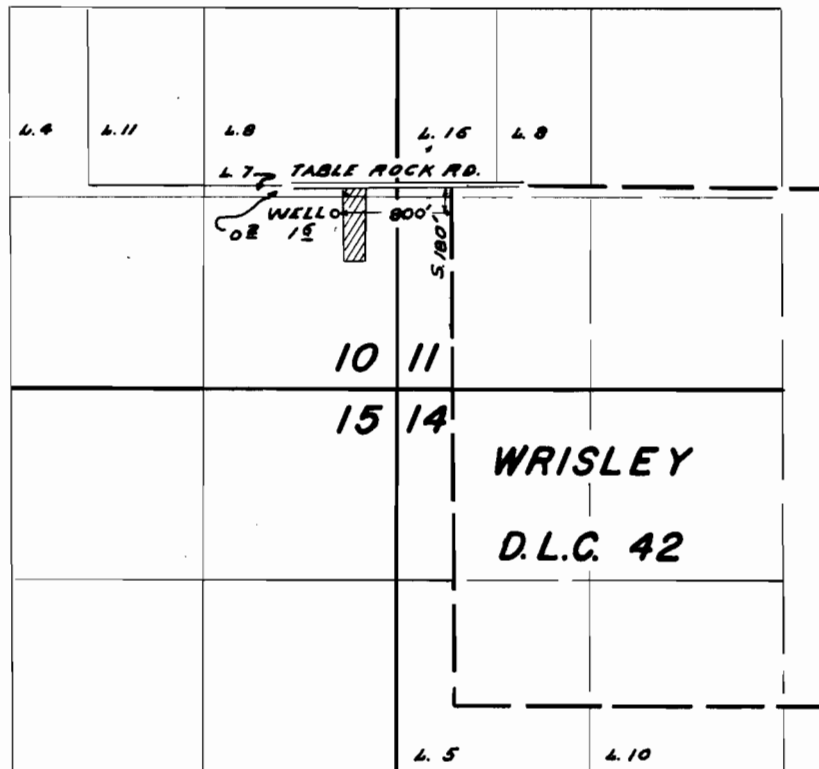

## FINAL PROOF SURVEY UNDER

Application No. 6-1730 Permit No. 6-1583  
IN NAME OF

ROBERT W. SAGE

Surveyed JULY 21 1965, by L. COLEBANK