


T.36S. R.3W. W.M.

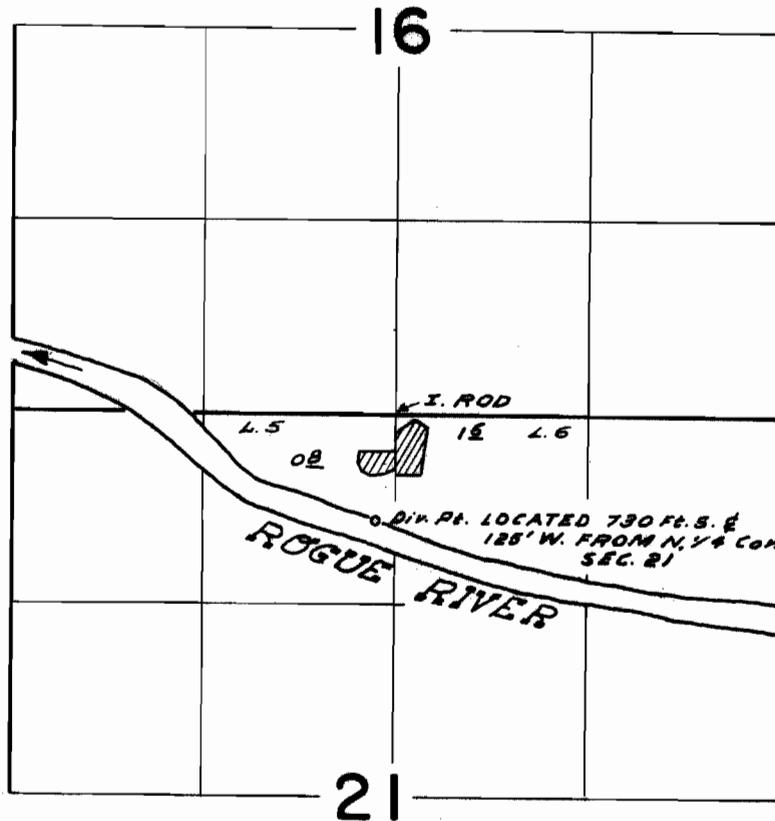

**FINAL PROOF SURVEY**  
UNDER

Application No. 34521 Permit No. 27112  
IN NAME OF

SCHOOL DISTRICT 6-C

Surveyed JULY 14 1965, by L. COLEBANK