


T. 36 S. R. 1 W. W.M.

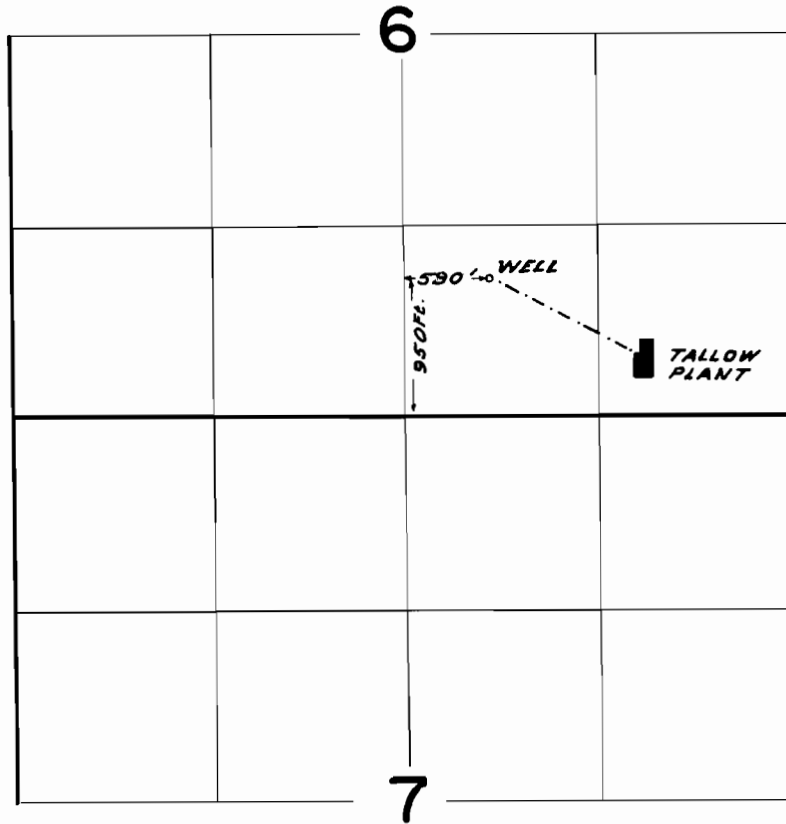

**FINAL PROOF SURVEY**  
UNDER

Application No. G-2593 Permit No. G-2400  
IN NAME OF

SOUTHERN OREGON TALLOW CO.

Surveyed JULY 13, 1965, by L. COLEBANK

1965-x 400