


T. 36S. R. 1W. W.M.

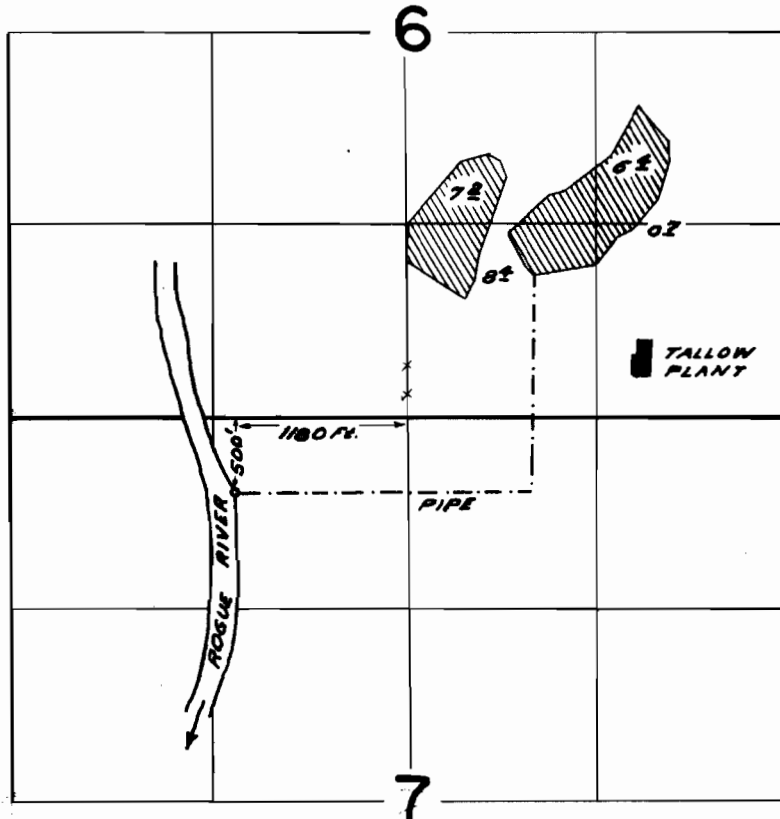

FINAL PROOF SURVEY
UNDER

Application No. 34718 Permit No. 27260
IN NAME OF

TRANS-BAY CONST. INC.

Surveyed JULY 7 1965, by L. COLEBANK