


R.15 S. T.4W. W.M.

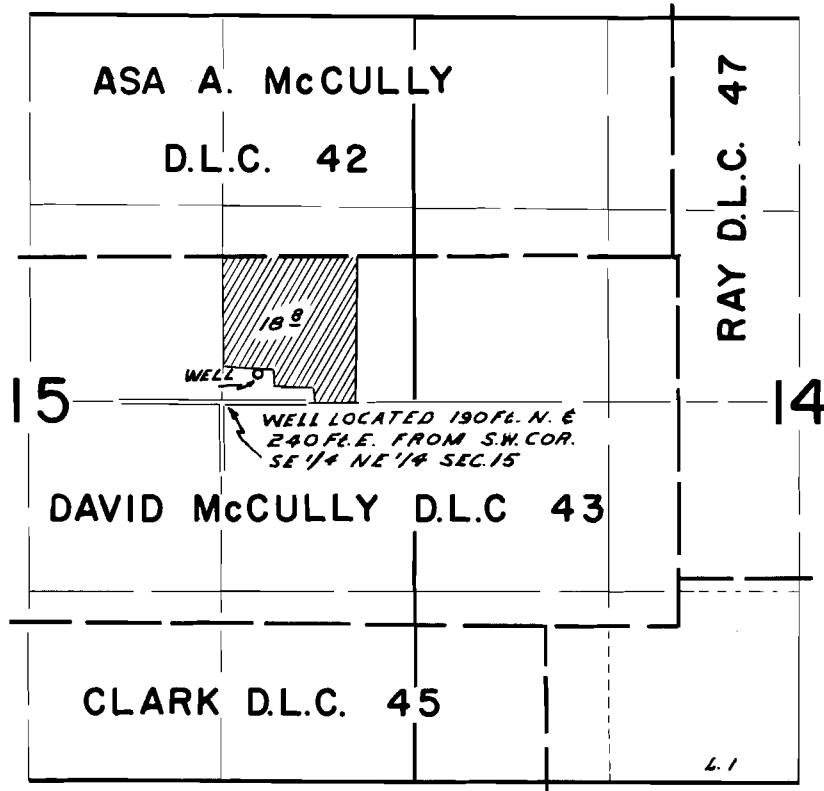

FINAL PROOF SURVEY
UNDER

Application No. G-2033 Permit No. G-1870
IN NAME OF

RODNEY L. POWELL

Surveyed SEPT. 28 1965, by L. COLEBANK