
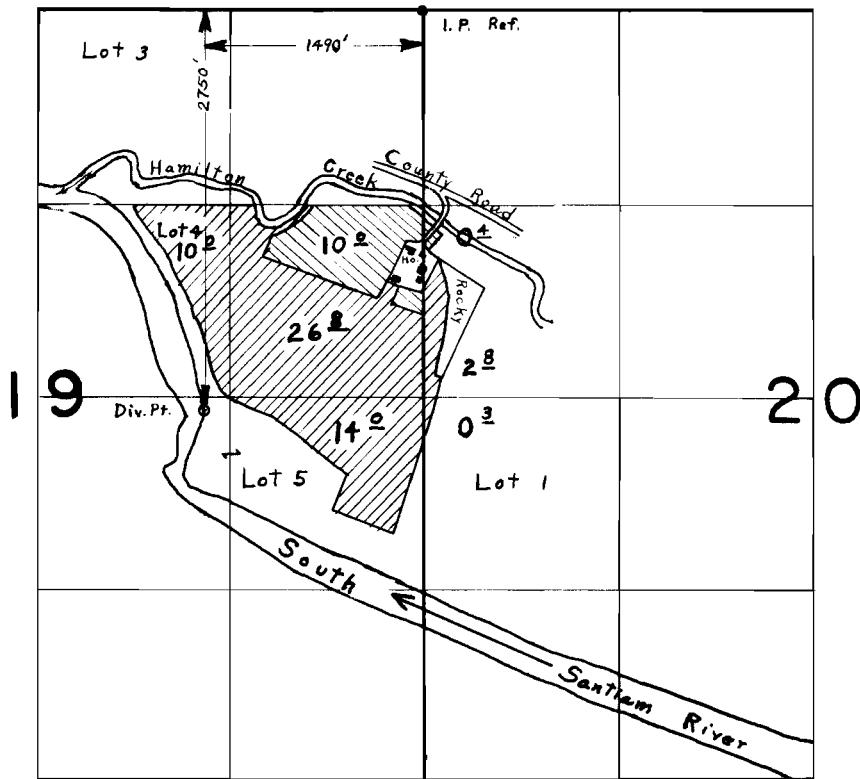


T.12S.R1W.W.M.

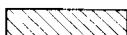

Primary 

Supplemental 

**FINAL PROOF SURVEY**  
UNDER

Application No. 37555 Permit No. 27983  
IN NAME OF

MRS. JOHN G. REED

Surveyed April 20 1966, by L. E. Gould