


T.13S.R.1 W.W.M.

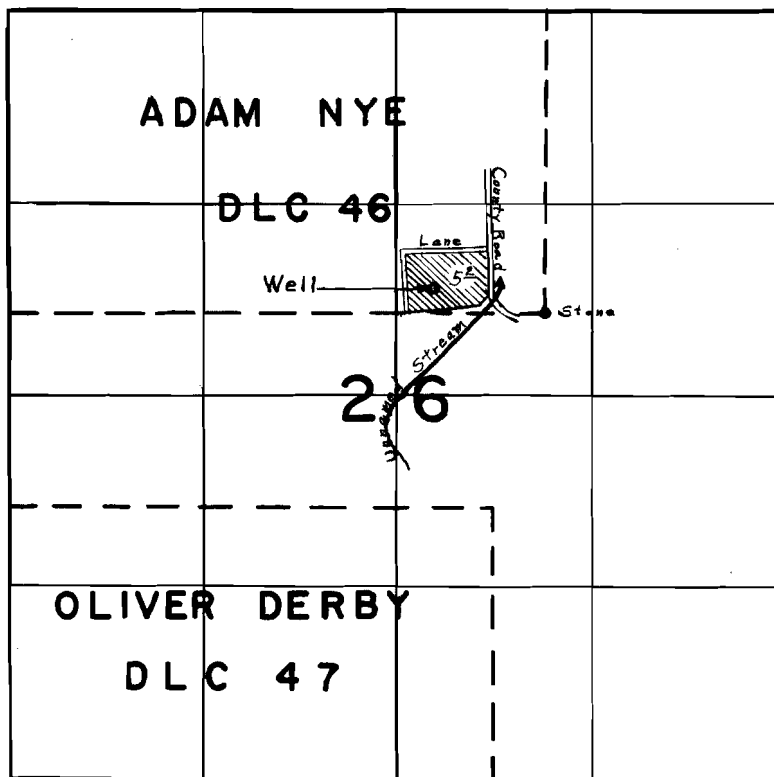

Well Located 160' N. & 760' W. From S.E. Corner DLC # 46

FINAL PROOF SURVEY
UNDER

Application No. G-3068 Permit No. G-2859
IN NAME OF

SWEET HOME CEMETERY MAINTENANCE DISTRICT

Surveyed APRIL 19, 1966, by L. E. GOULD