


T. 10S. R. 3W. W.M.

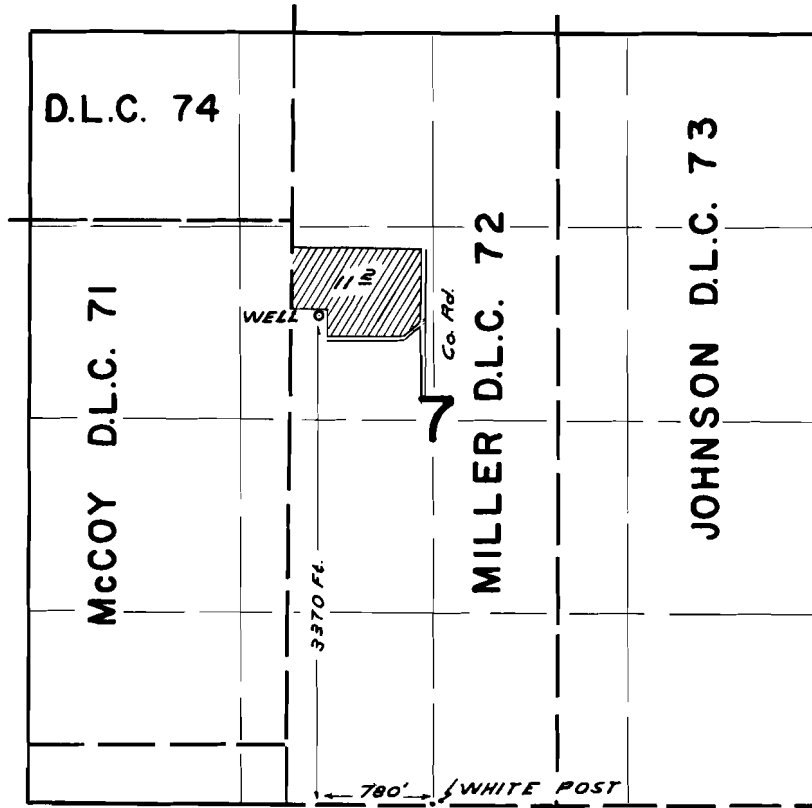

FINAL PROOF SURVEY
UNDER

Application No. G-2137. Permit No. G-1974
IN NAME OF

M. D. WAMSLEY

Surveyed SEPT. 8 1965, by L. COLEBANK