


# T.10S.R.1W.W.M.

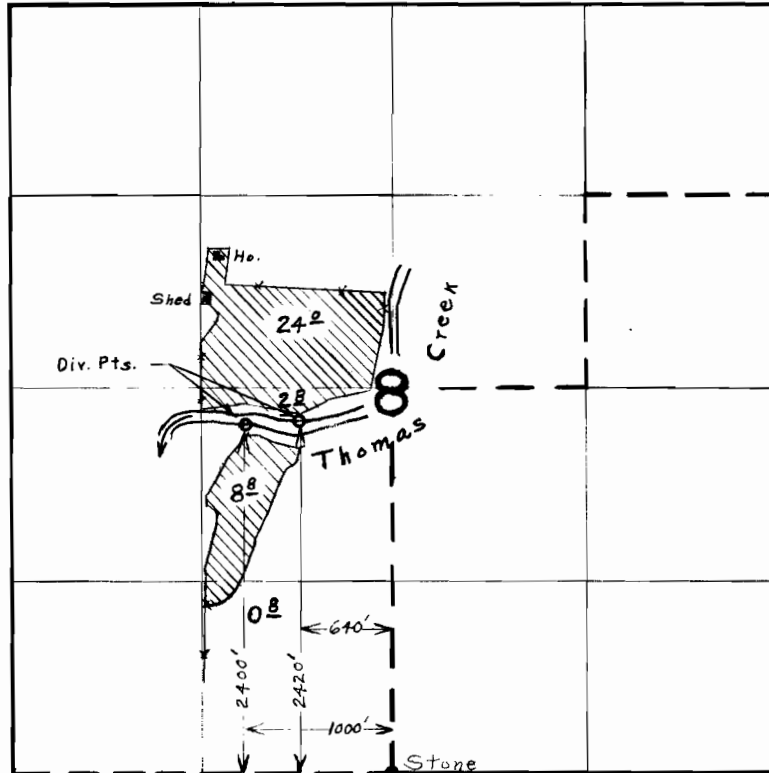

## FINAL PROOF SURVEY UNDER

Application No. 34674 Permit No. 27234  
IN NAME OF

Ollin L. & Virginia S. Wood

Surveyed April 25 1966. by R. E. Gould