


T. I. S. R. I. E. W. M.

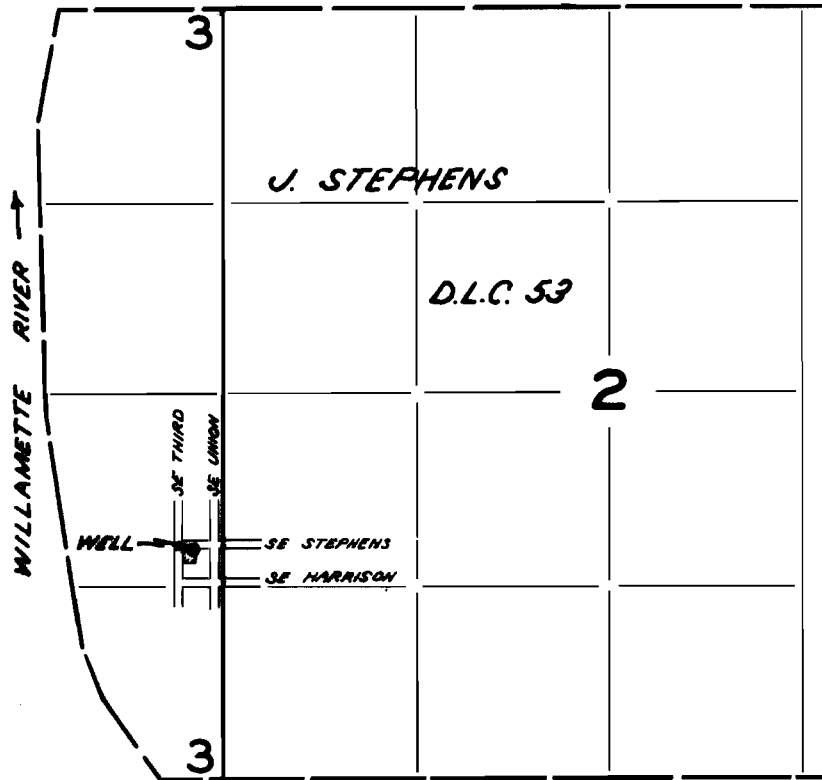

FINAL PROOF SURVEY
UNDER

Application No. G-1851 Permit No. G-1694
IN NAME OF

EAST SIDE PLATING WORKS, INC.

Surveyed Oct. 16 1964, by M. BISH