


T.6S. R.1W. W.M.

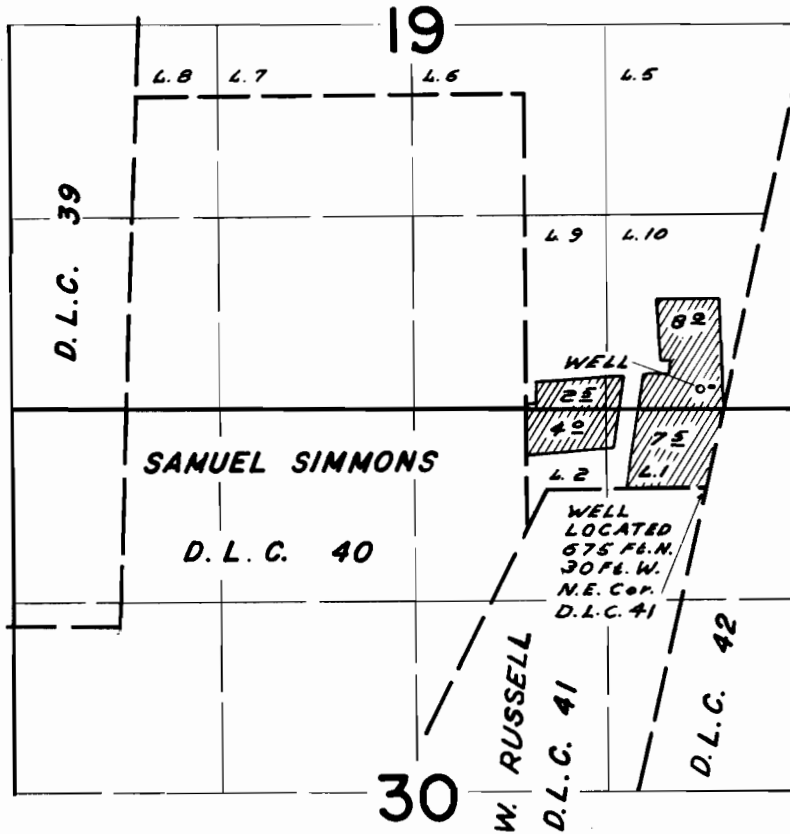

**FINAL PROOF SURVEY**  
UNDER

Application No. 6-2375 Permit No. 6-2186  
IN NAME OF

**R. H. BOEDIGHEIMER**

Surveyed JUNE 15 1965, by L. COLEBANK