


T.8S. R.4W. W.M.

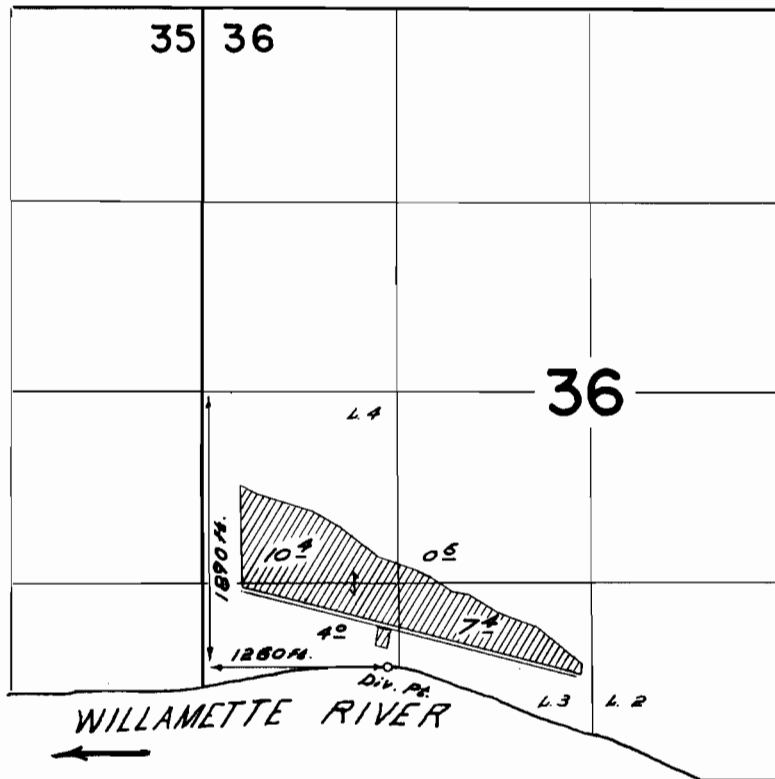

FINAL PROOF SURVEY
UNDER

Application No. 39150... Permit No. 29341.
IN NAME OF

.....ERNIE J. BRADTL.....

Surveyed JUNE 18 1965, by C. GARDNER.....