


T.8 S. R.1 W. W.M.

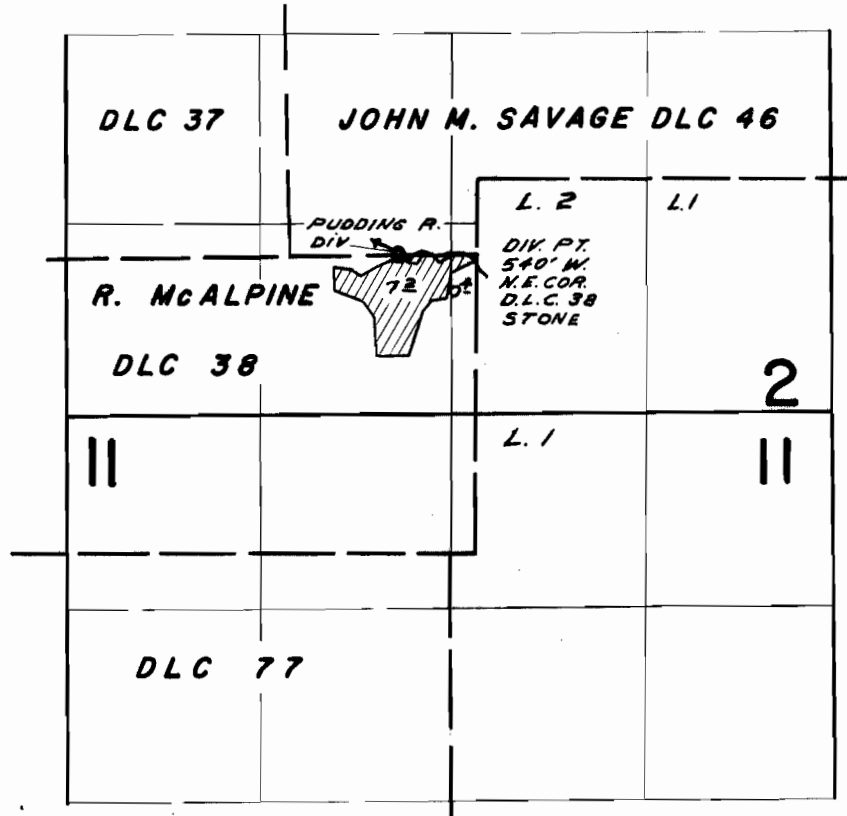

FINAL PROOF SURVEY
UNDER

Application No. 32994 Permit No. 26091
IN NAME OF

T. ROBERT FISHER

Surveyed APR. 14 1965, by L. COLEBANK