


T.6S. R.1W. W.M.

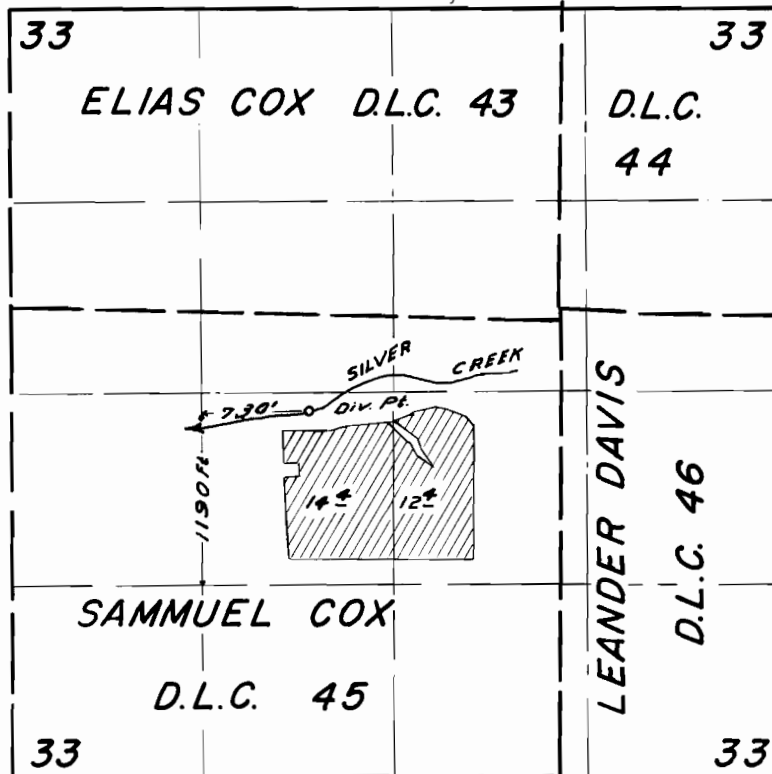

FINAL PROOF SURVEY
UNDER

Application No. 34541 Permit No. 27124
IN NAME OF

GLENN W. HANSBERRY

Surveyed JUNE 17 1965, by L. COLEBANK