


T. 8 S. R. 1 W. W. M.

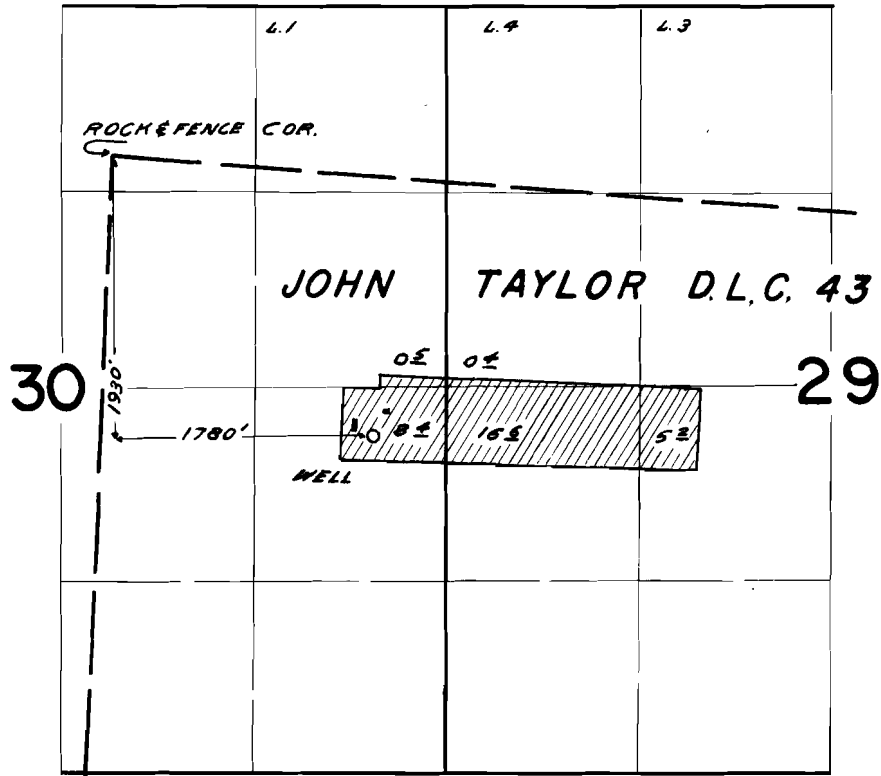

FINAL PROOF SURVEY UNDER

Application No. G-1946 Permit No. G-1796
IN NAME OF

FRANCIS L. HENDRICKS

Surveyed APR. 15, 1965, by L. COLEBANK.