


T.5S. R.1E. W.M.

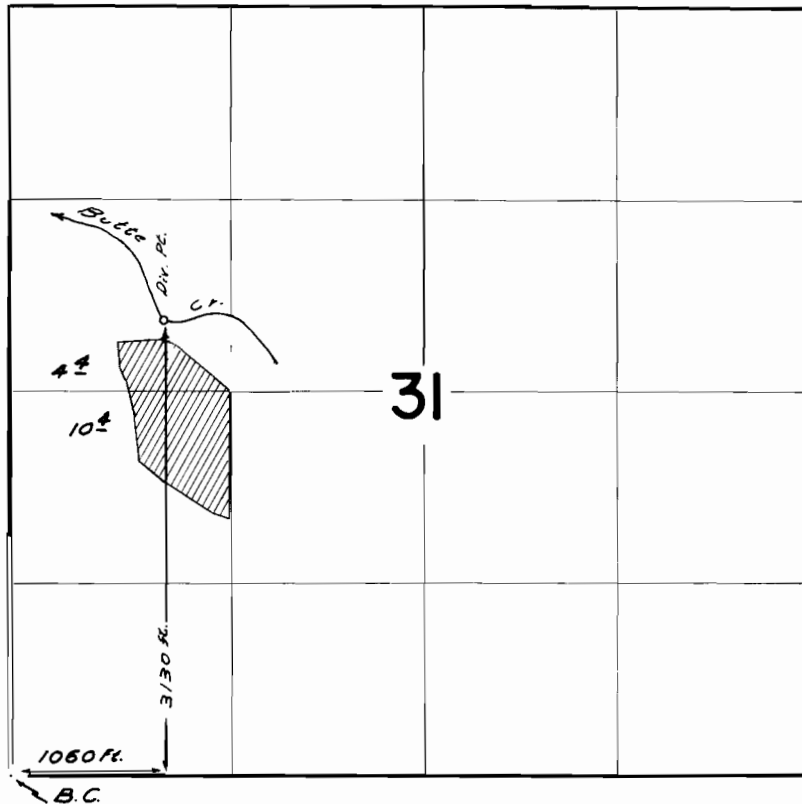

FINAL PROOF SURVEY
UNDER

Application No. **34481** Permit No. **27079**
IN NAME OF

ALMA & CLARENCE L. MEDACK

Surveyed **OCT. 21, 1965**, by **L. COLEBANK**