


T.6S. R.1W. W.M.

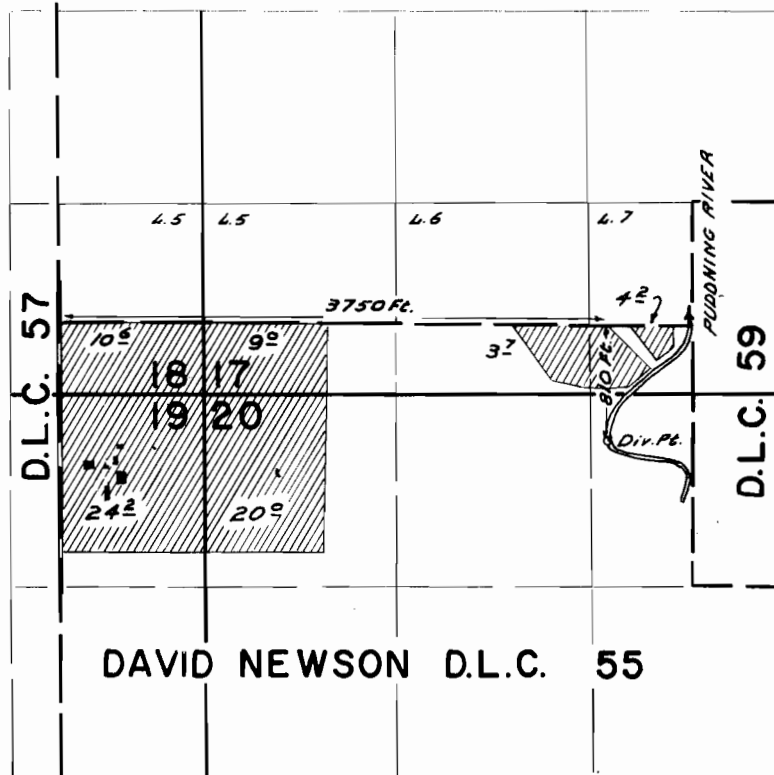

FINAL PROOF SURVEY
UNDER

Application No. 39572 Permit No. 29413
IN NAME OF

ALAN OBERSINNER

Surveyed AUG 20 1965, by C. GARDNER