


T.6S. R.1W. W.M.

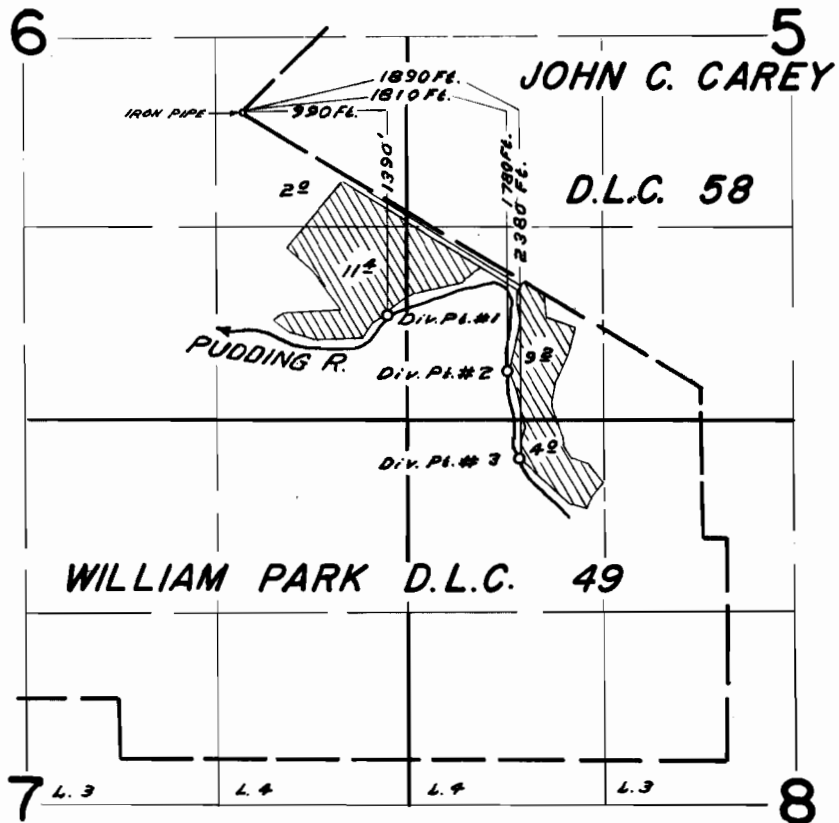

FINAL PROOF SURVEY
UNDER

Application No. 32004 Permit No. 25898
IN NAME OF
ESTATE OF
B. F. PAGE

Surveyed JUNE 17 1965, by L. COLEBANK