


T.7S.R.1W.W.M.

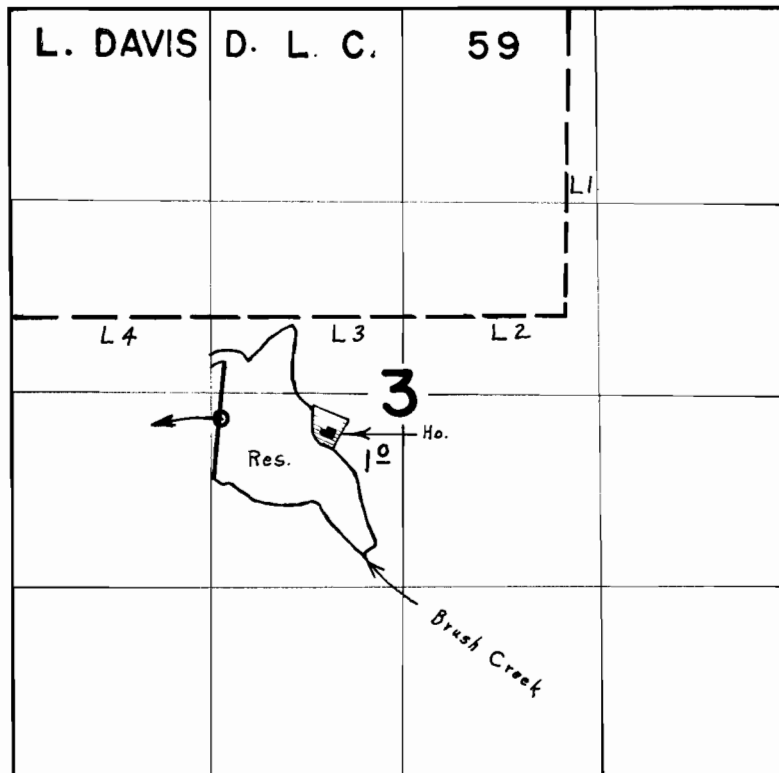

Div. Pt. Located 700' S. & 70' E. From the NW. Cor. Lot 3, Sec. 3

FINAL PROOF SURVEY
UNDER

Application No. 41622. Permit No. 31065
IN NAME OF

VIRGIL E. PETTIT

Surveyed Aug. 18, 1966, by L. E. Gould