


T. 6 S. R. 1 W. W. M.

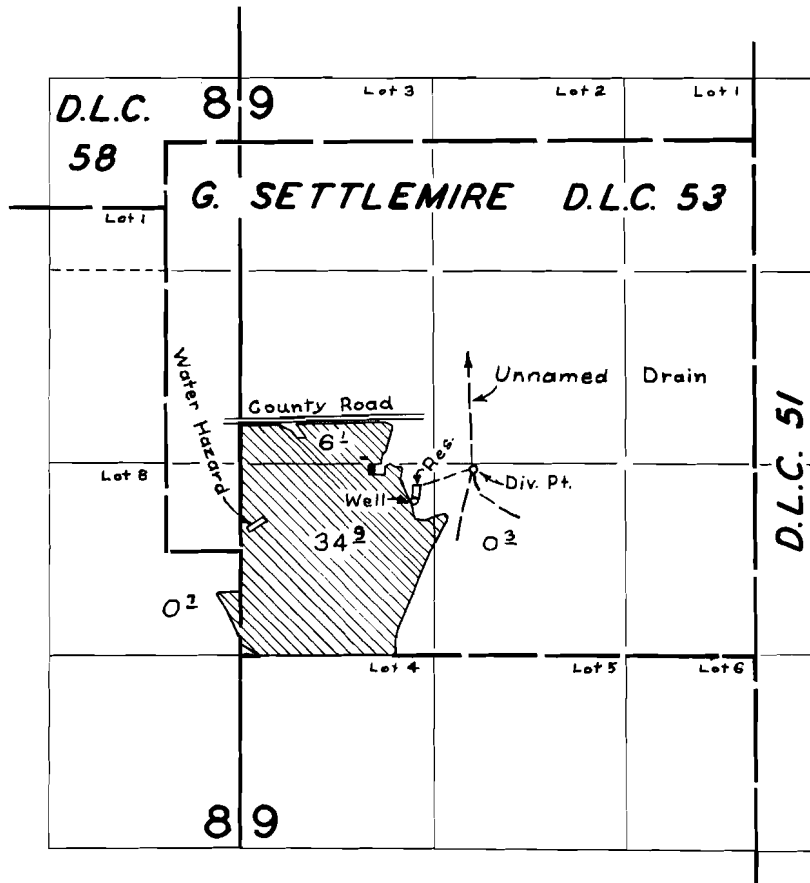

FINAL PROOF SURVEY UNDER

R-34407 R-2517
34408 27029
Application No. G-2435 Permit No. G-2244
IN NAME OF

WILLIAM SCHAFER

Surveyed JUNE 2 1964, by R. JACKSON