


T.6S. R.1W. W.M.

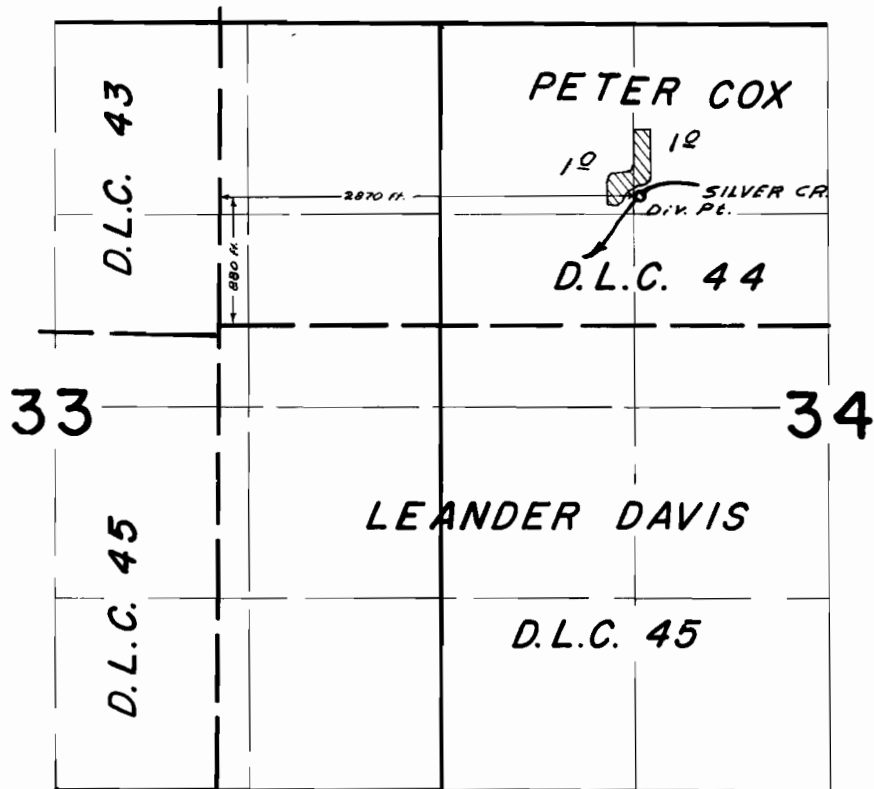

FINAL PROOF SURVEY
UNDER

Application No. 38755 Permit No. 28842
IN NAME OF

RALPH SCHEMME

Surveyed JUNE 15 1965, by L. COLEBANK