T.4S. R.2W. W.M.

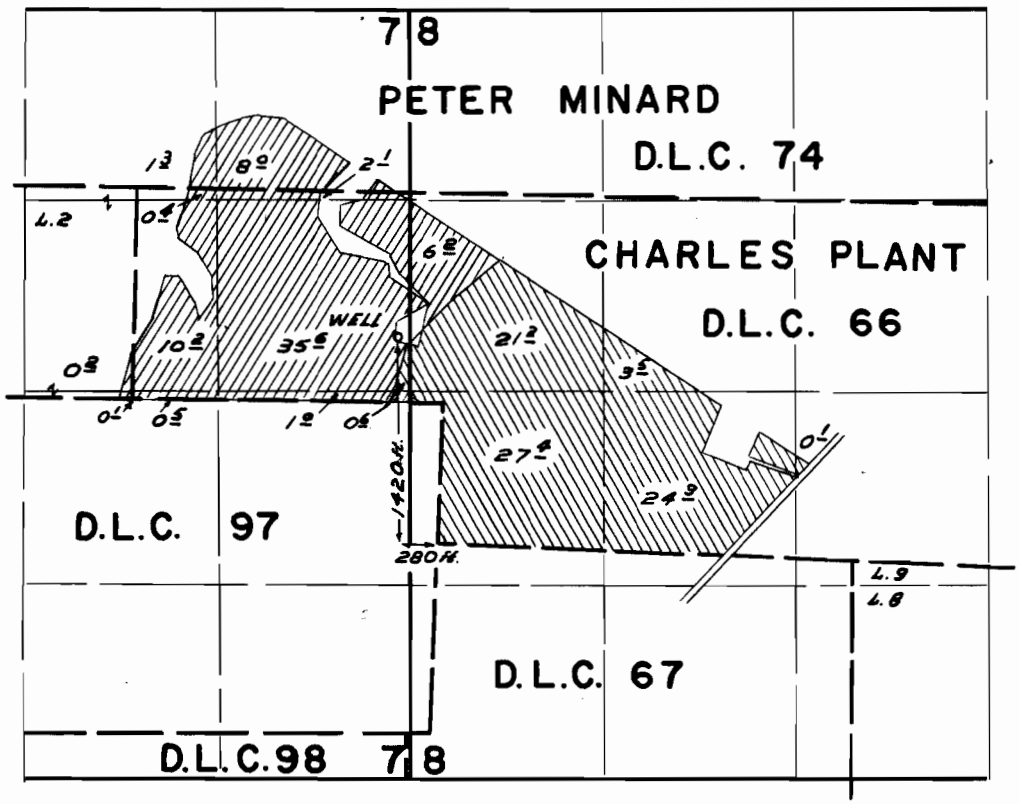

FINAL PROOF SURVEY
UNDER

Application No. G-2725 Permit No. G-2524
IN NAME OF

MILO SCHNEIDER

Surveyed AUG. 19 1965, by C. GARDNER

1965-0