T. 7 S. R. 2 W. W. M.

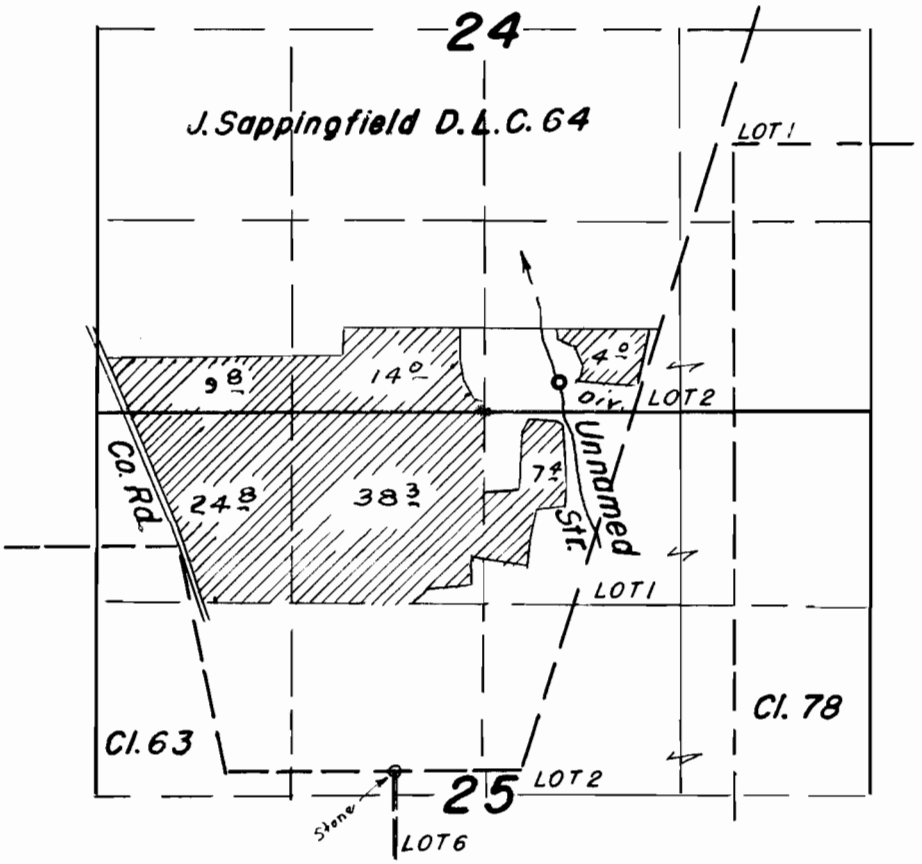

FINAL PROOF SURVEY
UNDER

Application No. 38071 Permit No. 28389
IN NAME OF

Clarence Simmons

Surveyed Nov. 7 1964, by F. Siegmund

2-1964-B