


T. I. N. R. I. E. W. M.

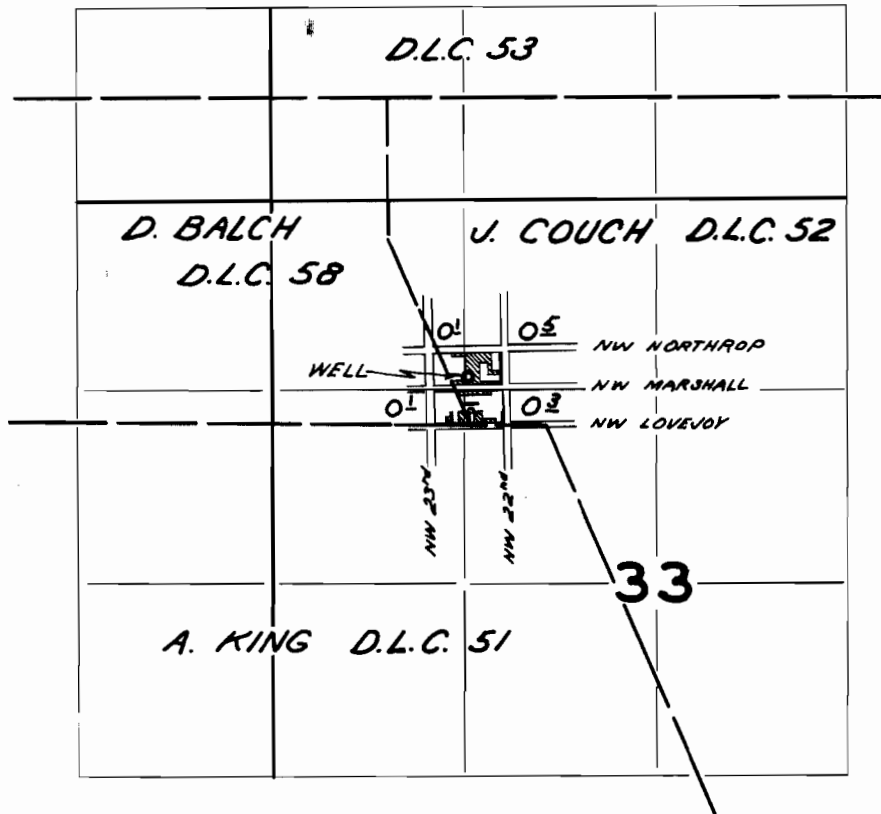

FINAL PROOF SURVEY
UNDER

Application No. G-2615 Permit No. G-2927

IN NAME OF

GOOD SAMARITAN HOSPITAL

Surveyed OCT. 13 1964, by M. BISH