


# T. I. S. R. I. E. W. M.

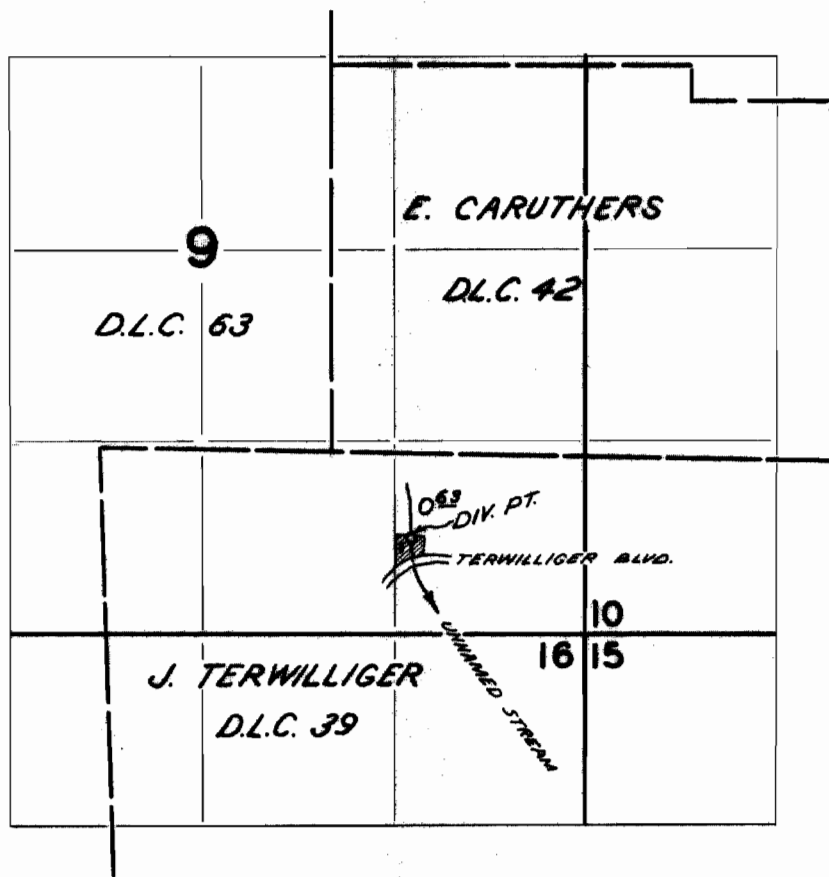

## FINAL PROOF SURVEY UNDER

Application No. 34904 Permit No. 26927  
IN NAME OF

CHARLES F. & THELMA NORRIS

Surveyed OCT. 16 1964, by M. BISH