


# T. I. S. R. I. E. W. M.

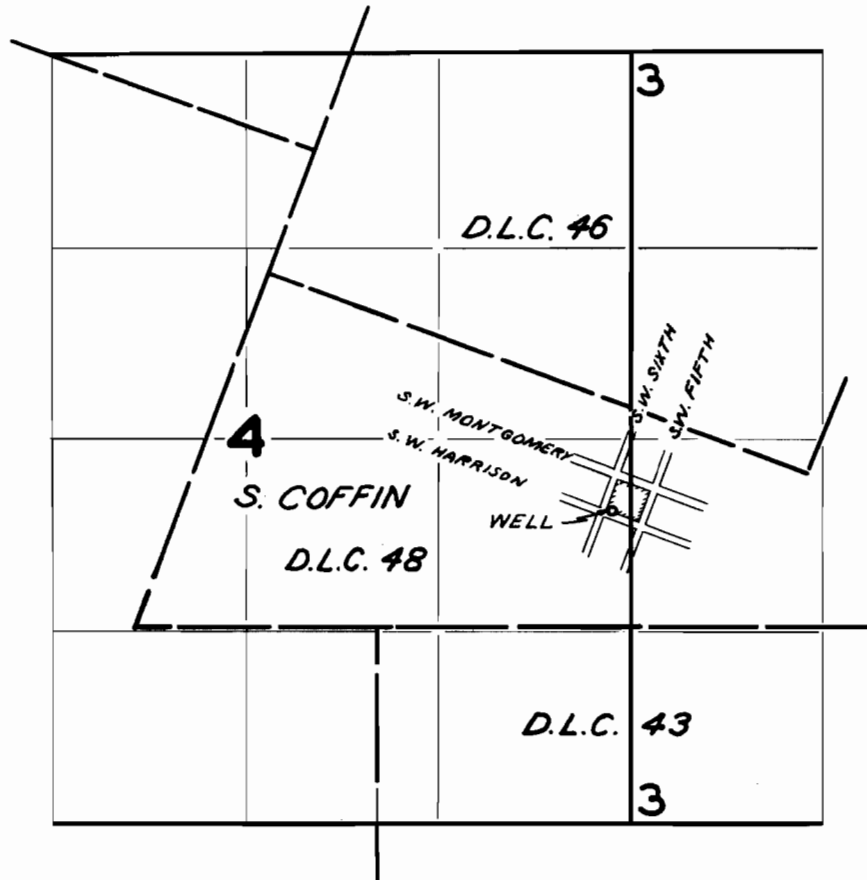

## FINAL PROOF SURVEY UNDER

Application No. G-2387 Permit No. G-2205  
IN NAME OF

NORTHWEST HOSPITAL SERVICE

Surveyed Oct. 16, 1964, by M. BISH