T.1N. R.2E. W.M.

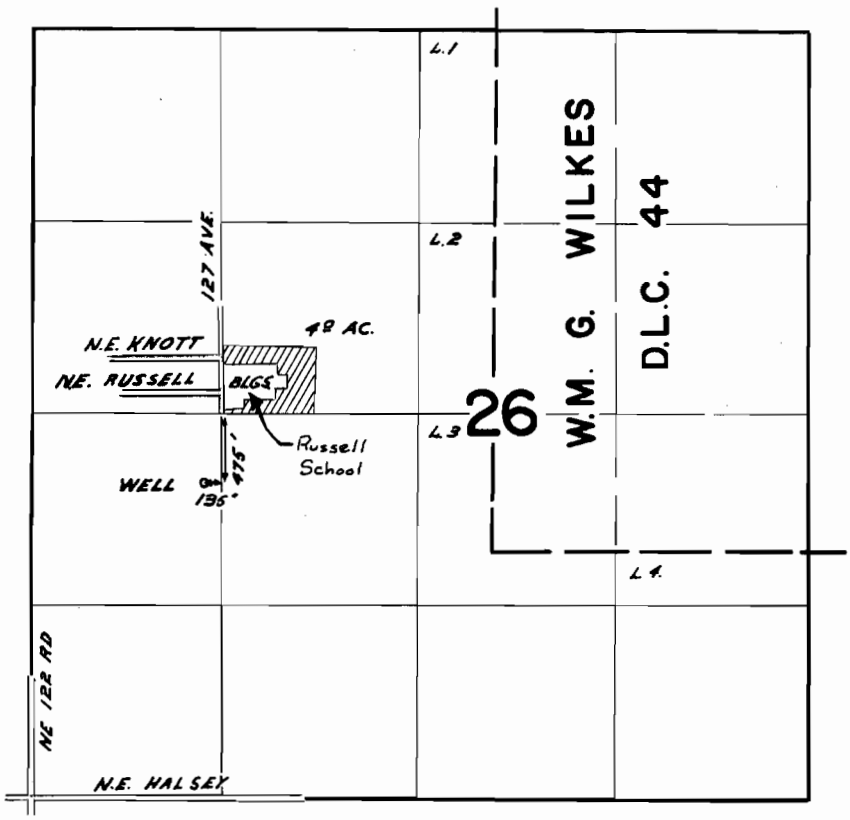

FINAL PROOF SURVEY
UNDER

Application No. G-2487 Permit No. G-2296
IN NAME OF

PARKROSE SCHOOL DIST. No. 3 ,

Surveyed SEPT. 8 1965, by C. GARDNER

1965 Q 34.