


T. 8 S. R. 5 W. W.M.

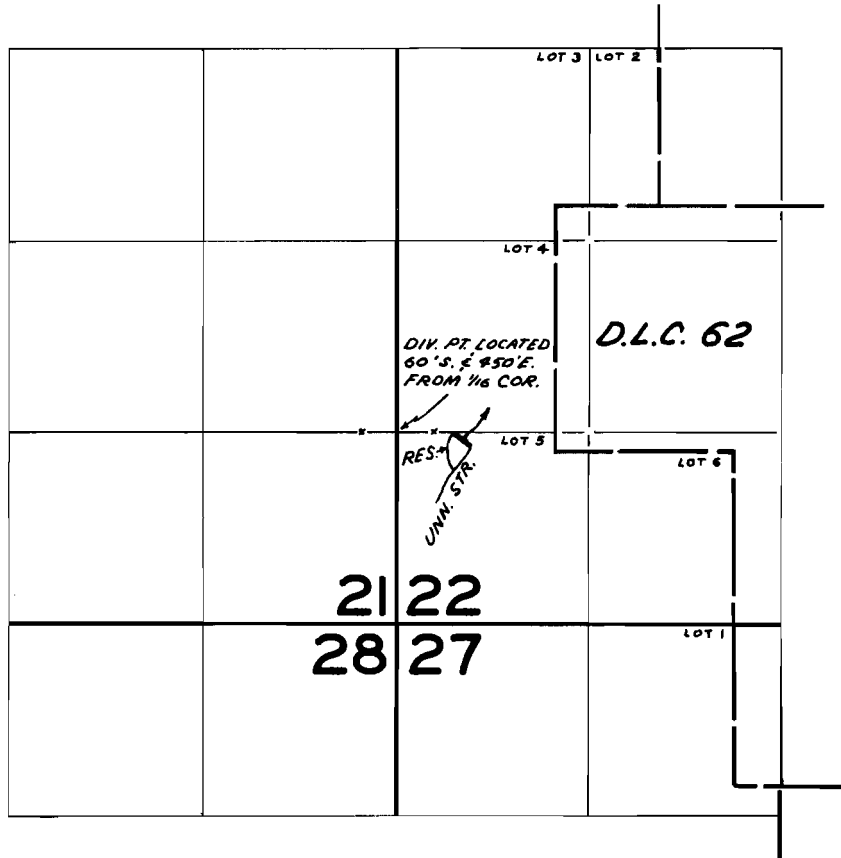

FINAL PROOF SURVEY
UNDER

Application No. R-40448 Permit No. R-4537
IN NAME OF

MARLIN BURELBACH

Surveyed AUG. 6 1965, by C. GARDNER