


T.7S. R.4W. W.M.

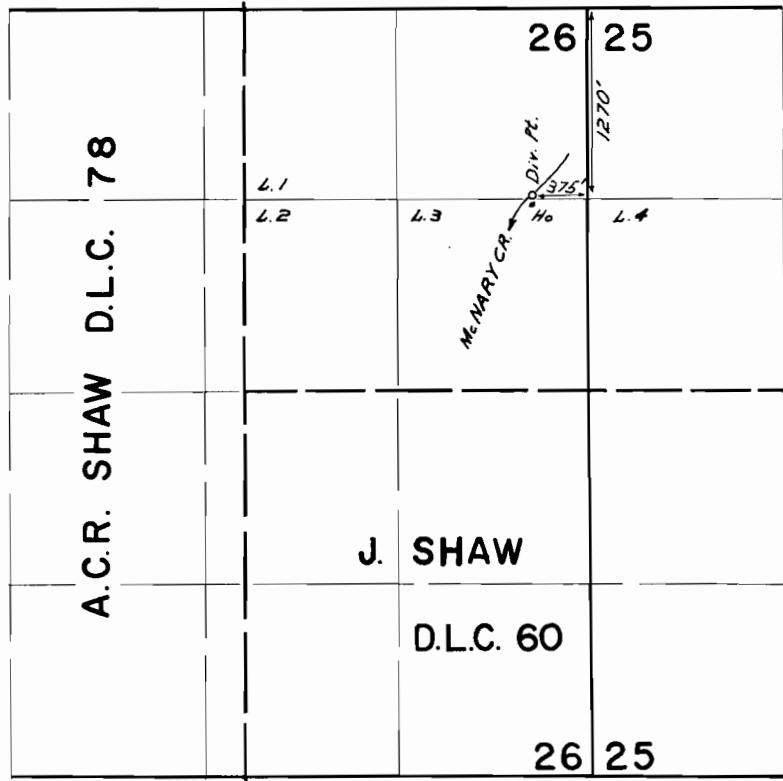

FINAL PROOF SURVEY
UNDER

Application No. **39746** Permit No. **29562**
IN NAME OF

KILE J. COOK

Surveyed **AUG. 3 1965**, by **C. GARDNER**