


T.10S. R.4W. W.M.

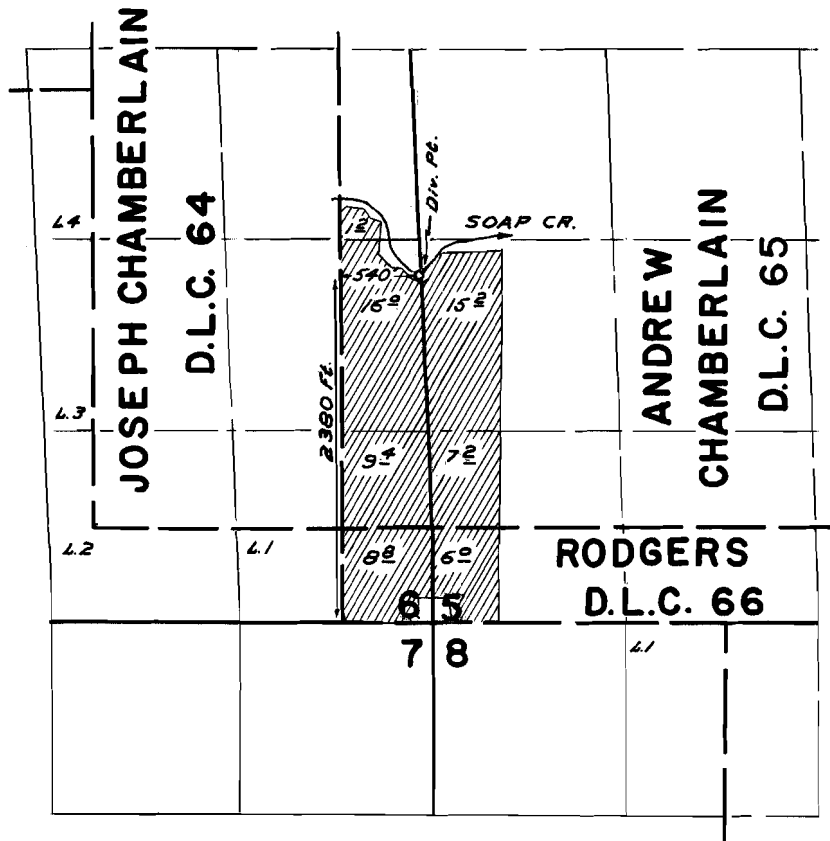

**FINAL PROOF SURVEY**  
UNDER

Application No. 40760 Permit No. 30254  
IN NAME OF

EUGENE V. DANNEN.

Surveyed AUG. 16 1965, by C. GARDNER.