


T. 7&8 S. R. 6 W. W.M.

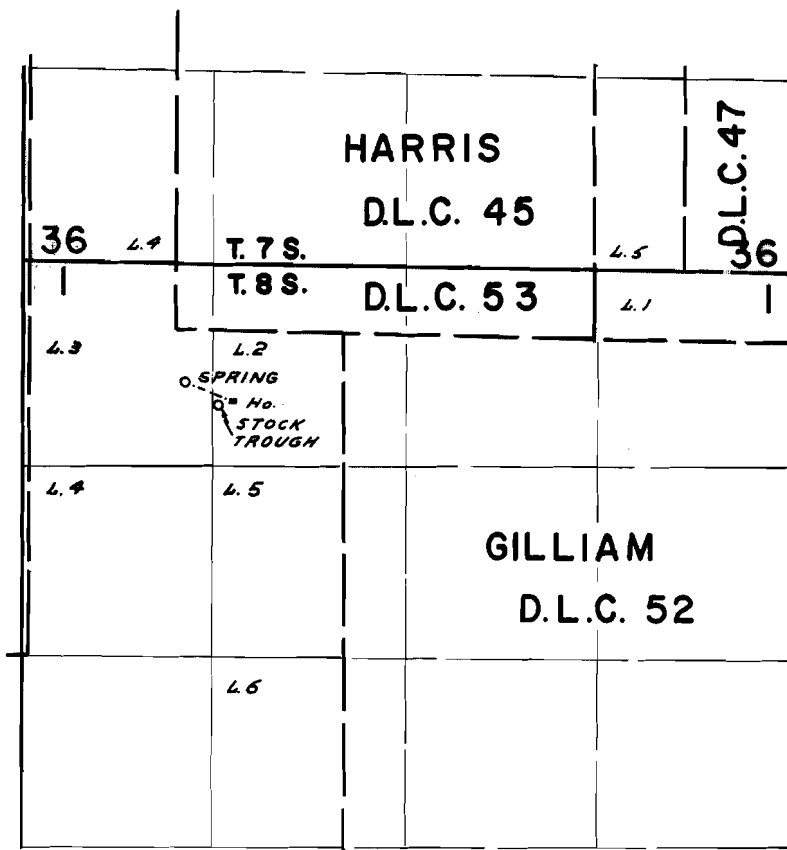

SPRING LOCATED 360 Ft. S. & 80 Ft. E. FROM S.W. COR. D.L.C. 53

FINAL PROOF SURVEY UNDER

Application No. 40278 Permit No. 30119
IN NAME OF

EDWARD A. HEWITT

Surveyed Aug. 18 1965, by C. GARDNER