


# T. 7 & 8 S. R. 6 W. W.M.

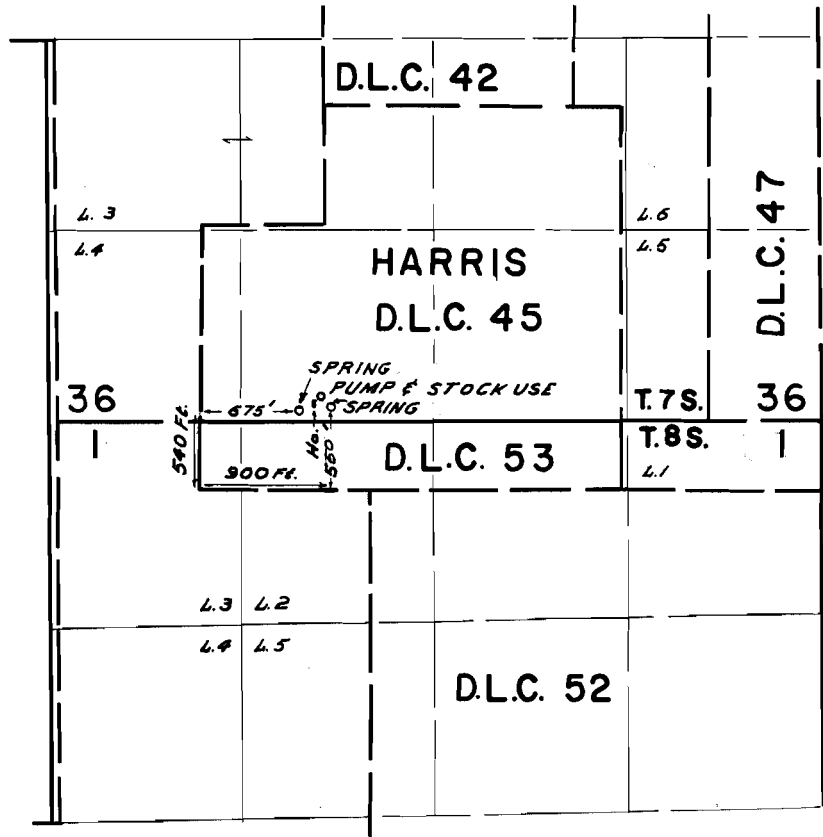

## FINAL PROOF SURVEY UNDER

Application No. 40277 Permit No. 30118  
IN NAME OF

MAXINE E. HEWITT

Surveyed Aug. 18 1965, by C. GARDNER