


28642

T.4S. R.13E. W.M.

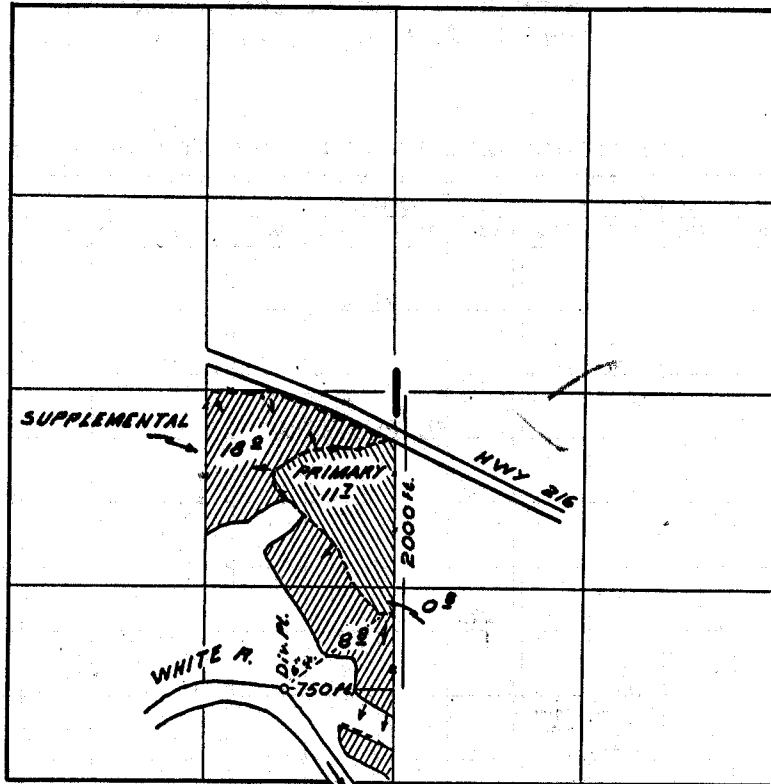

**FINAL PROOF SURVEY**  
UNDER

Application No. 38459 Permit No. 28642  
IN NAME OF

R. L. ASHLEY

Surveyed JUNE 9 1965, by C. GARDNER.