


T. 3 S.

R.4 W.

W. M.

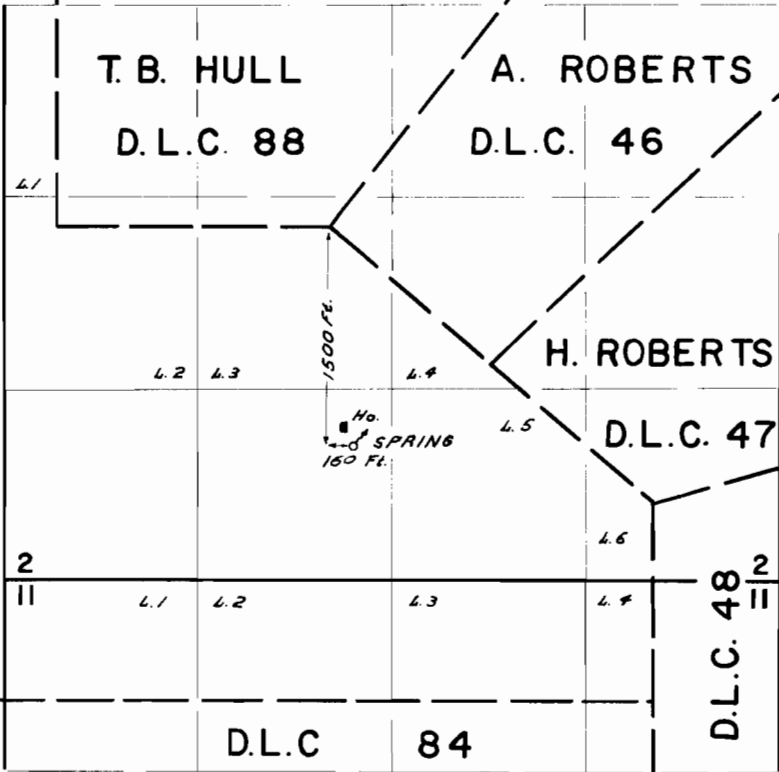

FINAL PROOF SURVEY

UNDER

Application No. **34262** Permit No. **27242**
IN NAME OF

PAUL D. & VIOLET M. ARMOUR

Surveyed AUG 17 1965, by L. COLEBANK