


T.4S. R.3W. W.M.

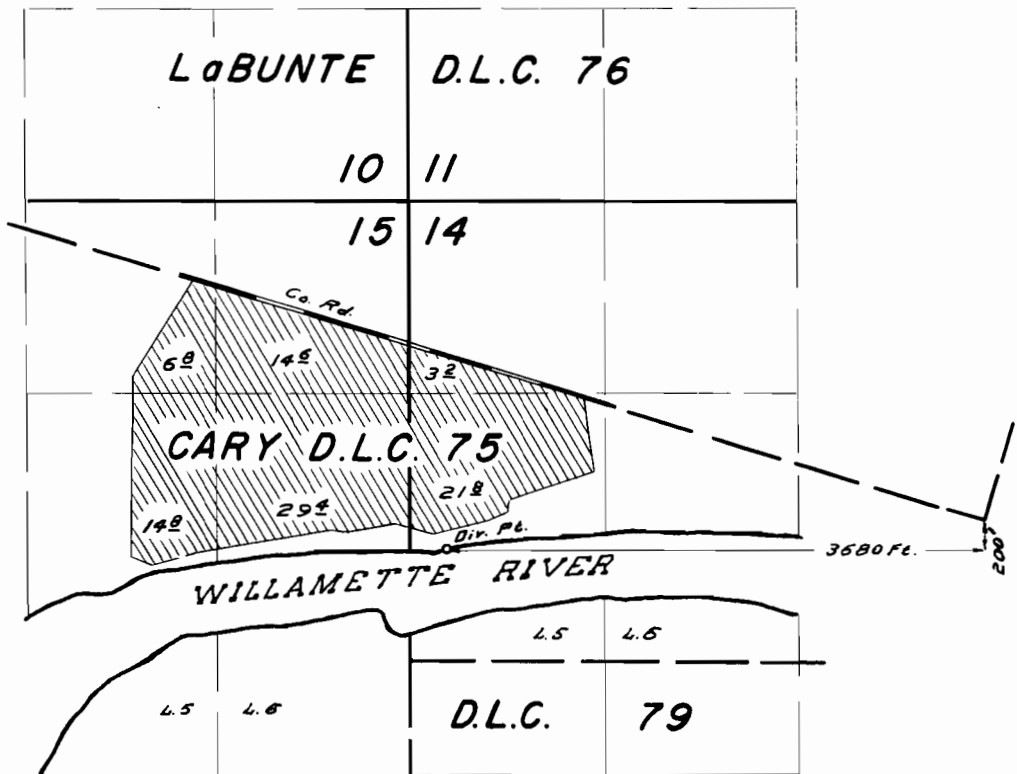

**FINAL PROOF SURVEY**  
UNDER

Application No. **38774** Permit No. **28848**  
IN NAME OF

**BONNIEMOOR FARMS**

Surveyed **AUG 3** 1965, by **L. COLEBANK**