


T. 3 S. R. 5 W. W. M.

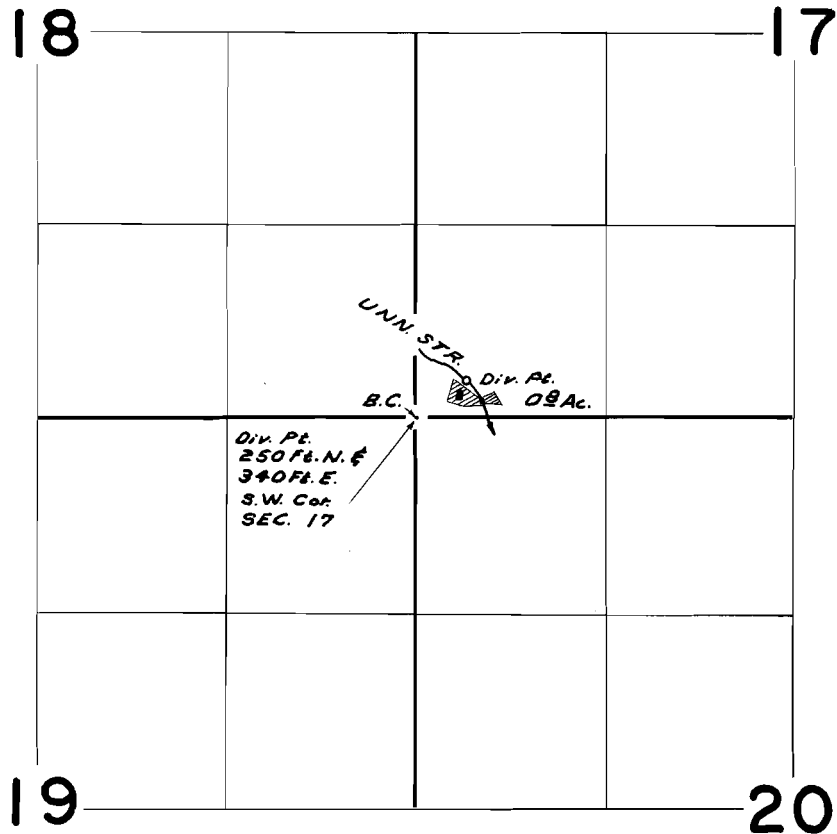

FINAL PROOF SURVEY
UNDER

Application No. 40228 Permit No. 30003
IN NAME OF

EDWARD D. BOWE

Surveyed AUG 4 1965, by L. COLEBANK