


# T.5S.R.5W.W.M.

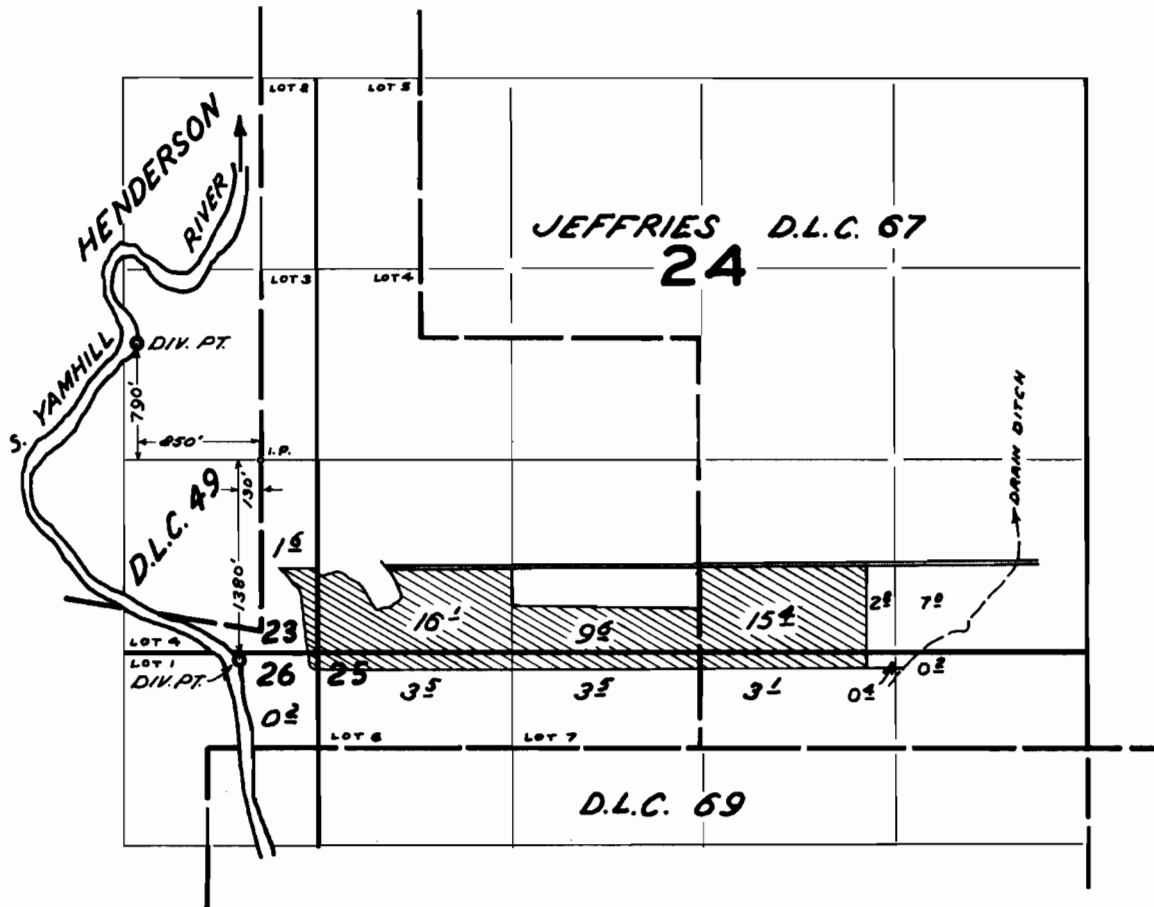

## FINAL PROOF SURVEY UNDER

Application No. 40398 Permit No. 3023  
IN NAME OF

D.K. HOWARD

Surveyed AUG. 8 1965, by R. JACKSON