


T.4S. R.3W. W.M.

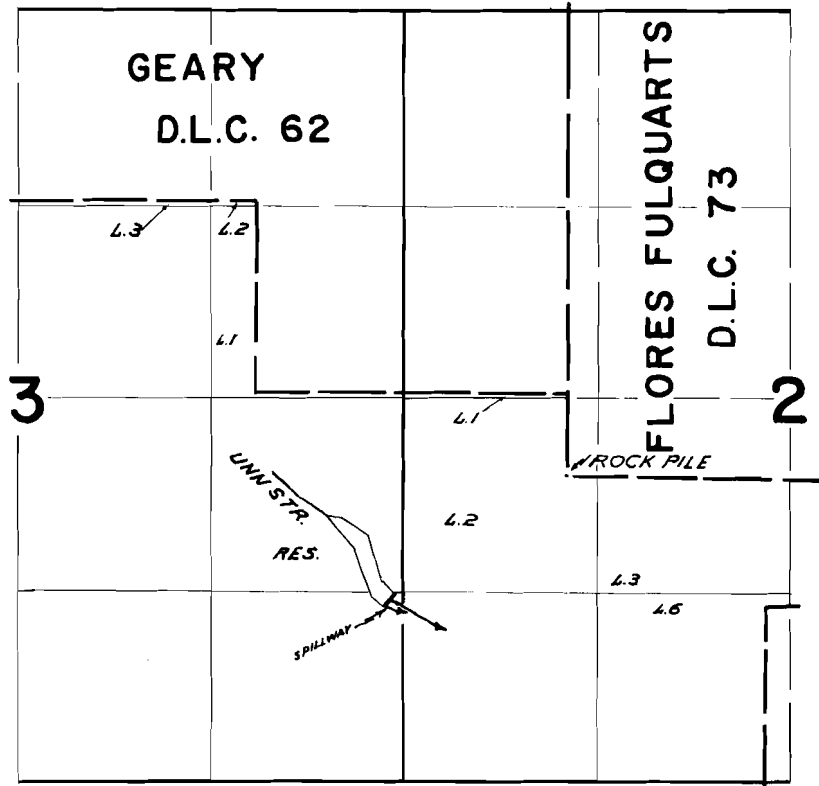

FINAL PROOF SURVEY
UNDER

Application No. **R-38455** Permit No. **R-3225**
IN NAME OF

ROBERT A. & DOROTHY R. PAINE

Surveyed **NOV. 11, 1965**, by **L. COLEBANK**