


T. 28 S., R. 14 W., W.M.

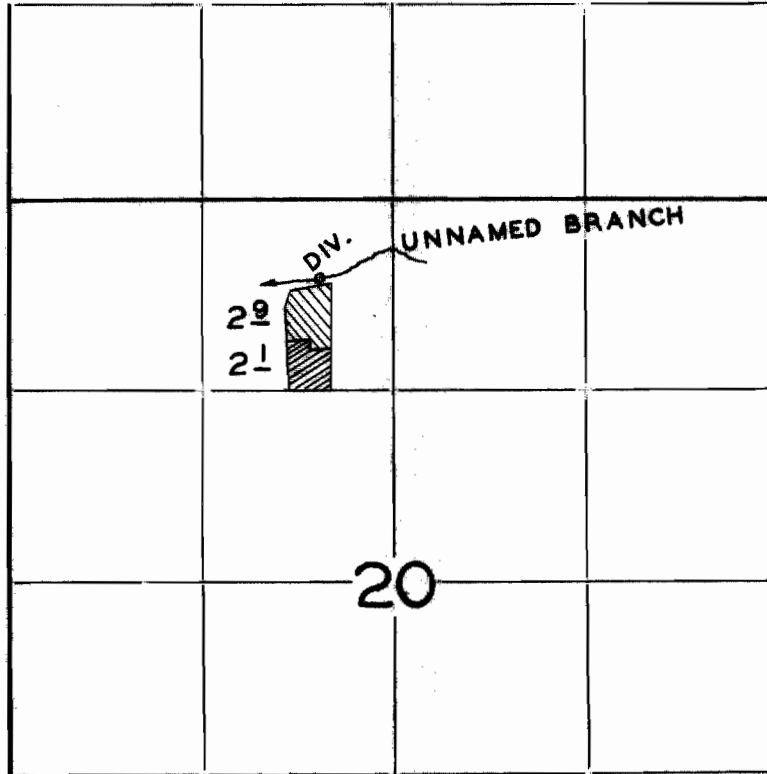

FINAL PROOF SURVEY
UNDER

Application No. 20891 Permit No. 16363
IN NAME OF

CARL INGRAM

Surveyed 6-14 1960, by M. BISH