


T. 4 S. R. 2 W. W. M.

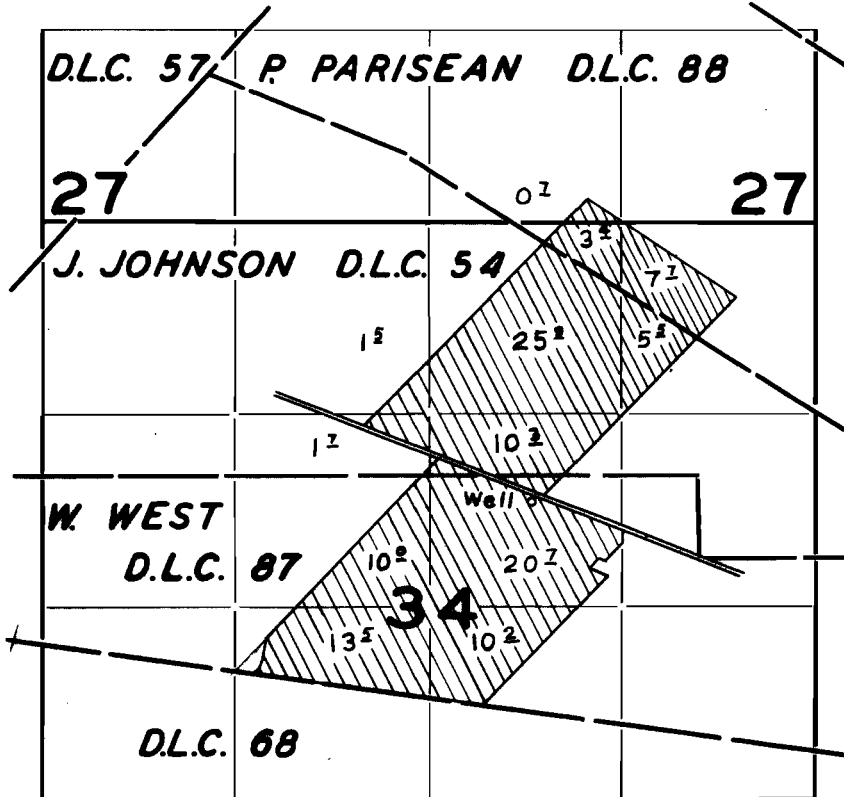

FINAL PROOF SURVEY
UNDER

Application No. G-2178... Permit No. G-2008...
IN NAME OF

.....**WALTER J. BIZON**.....

Surveyed APR 10... 19 64, by R. JACKSON.....