


T.485S. R.2W. W.M.

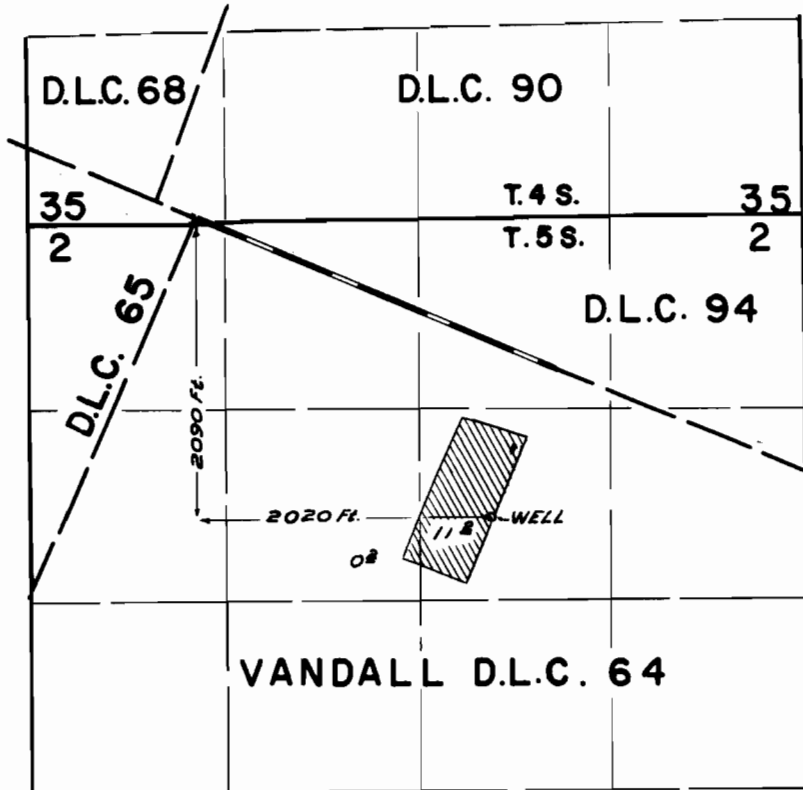

**FINAL PROOF SURVEY
UNDER**

Application No. G-2146 Permit No. G-1980
IN NAME OF

HAROLD V. & NELLIE C. ESKELSEN

Surveyed AUG 20 1965, by C. GARDNER