
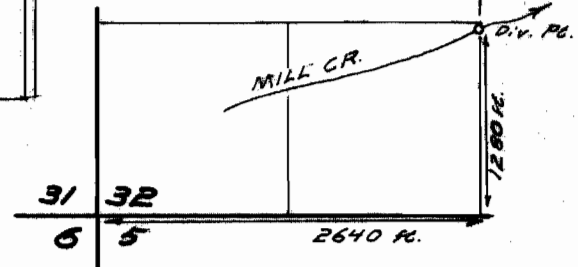
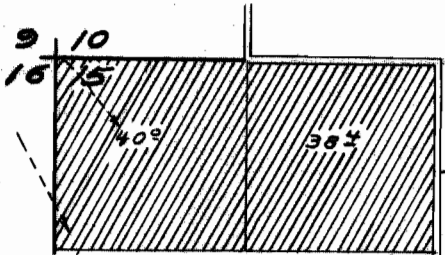


T.8S. R.39E.W.M.

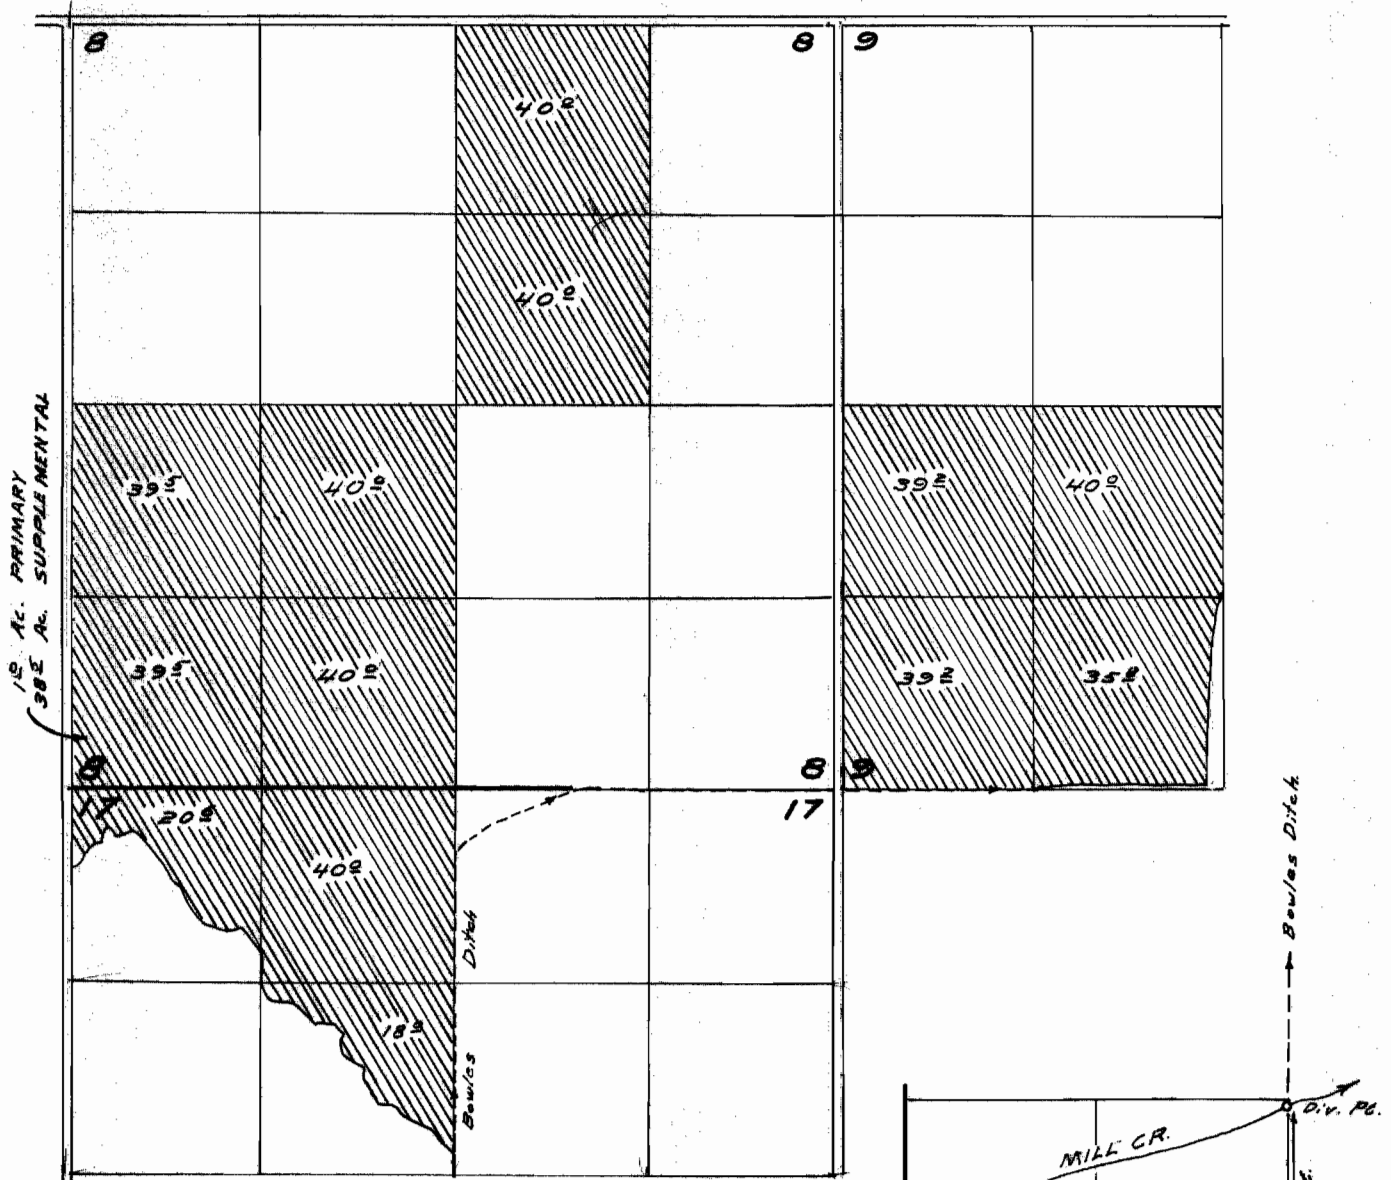

FINAL PROOF SURVEY
UNDER

Application No. 34539 Permit No. 27122
IN NAME OF

N. E. DODD

Surveyed Nov. 16 & 17 1964, by C. Gardner