
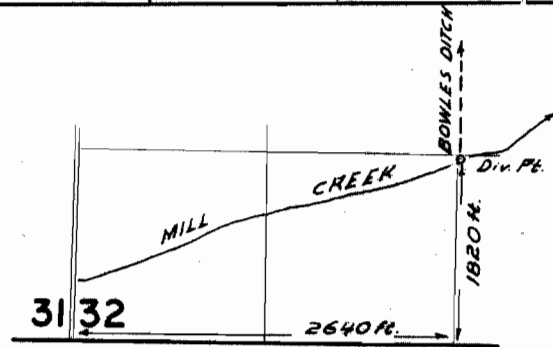


T. 8 S. R. 39 E. W. M.

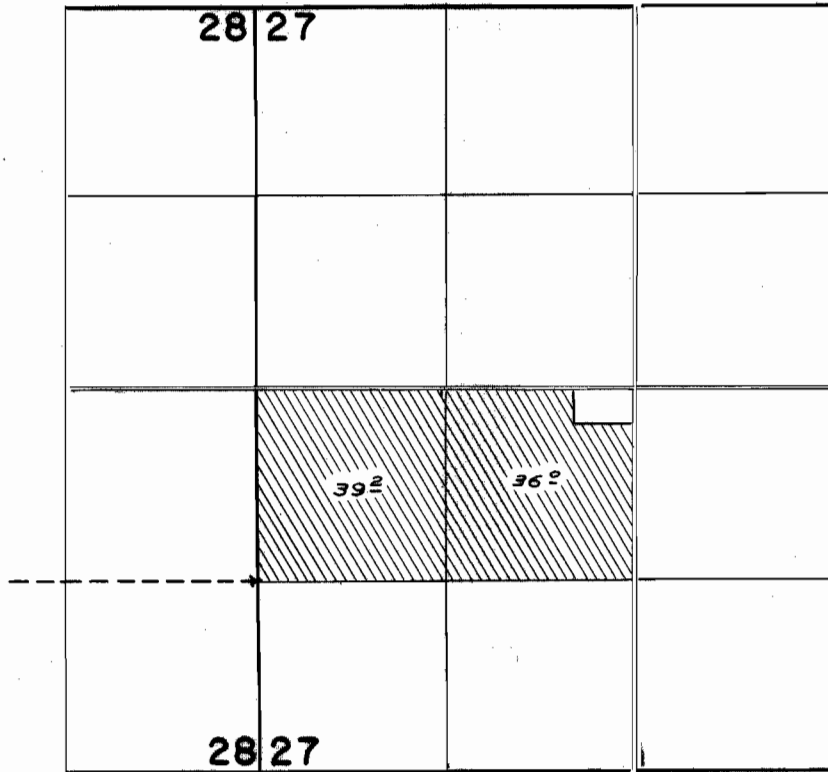

**FINAL PROOF SURVEY**  
UNDER

Application No. 34537 Permit No. 27121  
IN NAME OF

NELLIE M. IRBY

Surveyed NOV. 16, 17 1965, by C. GARDNER