


T. 8 S. R. 39 E. W. M.

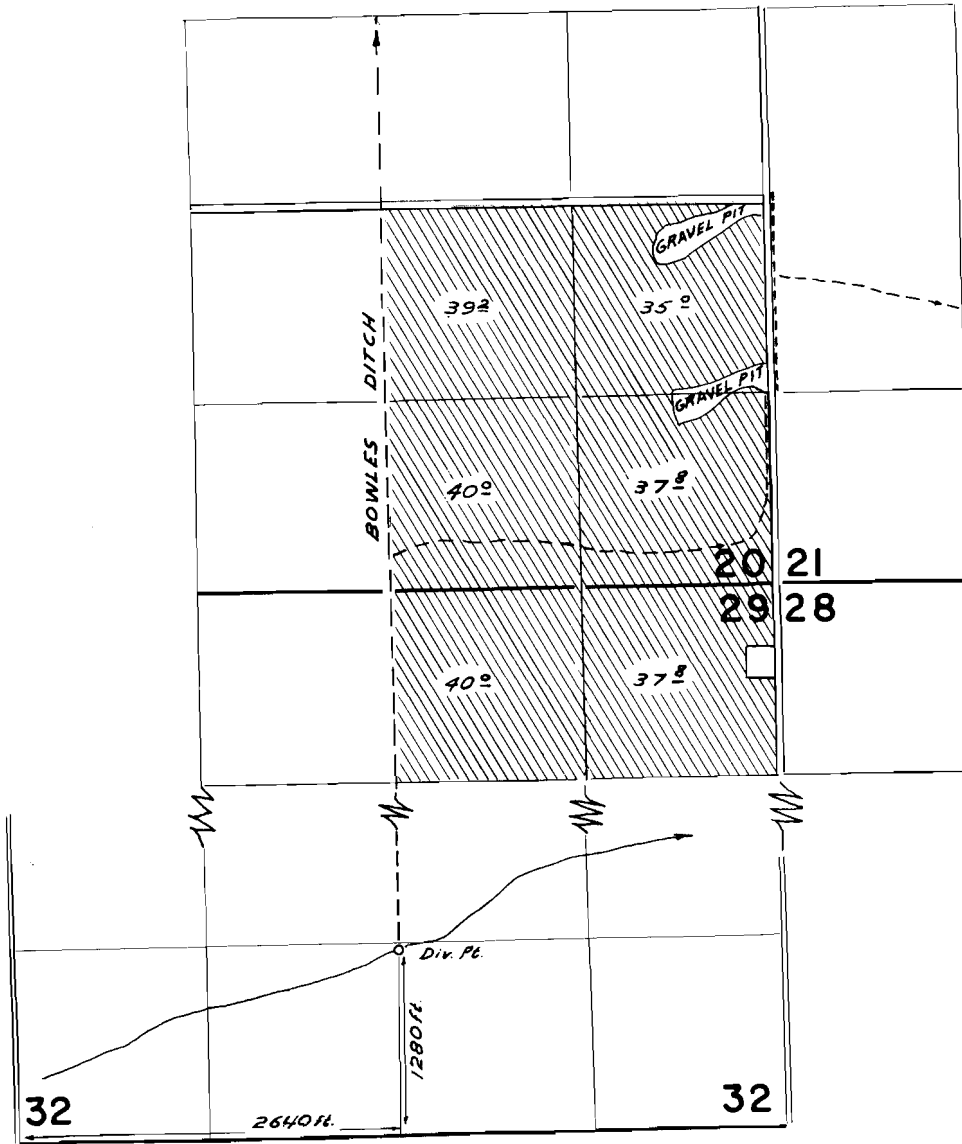

FINAL PROOF SURVEY

UNDER

Application No. 33512 Permit No. 26506
IN NAME OF

ALVIN F. MOSER

Surveyed NOV. 16,17 1964, by C. GARDNER.