


T. 8 S. R. 39 E. W. M

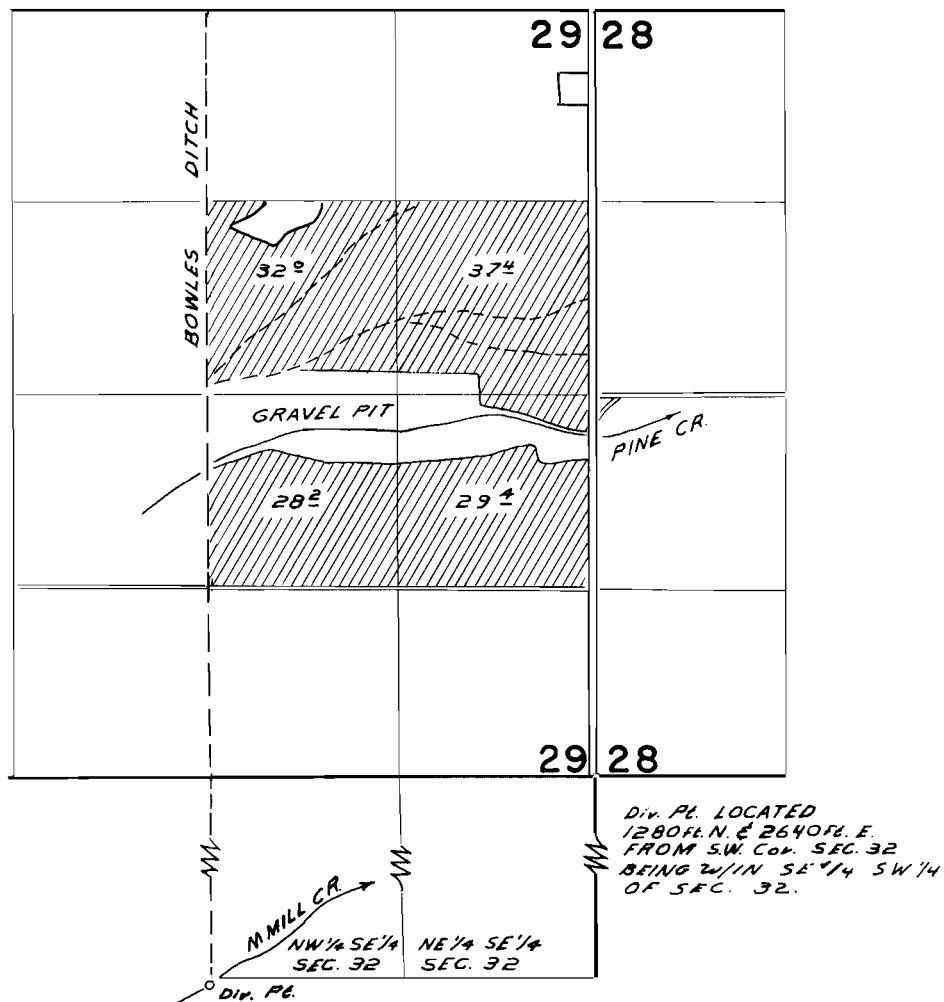

FINAL PROOF SURVEY
UNDER

Application No. 33514... Permit No. 26508..
IN NAME OF

FRED J. SCHUETZ

Surveyed NOV. 16, 17 1964, by C. GARDNER